

MISSISSIPPI
 BOARD OF WATER COMMISSIONERS
 416 North State Street
 Jackson, Mississippi 39201

CODED

WATER WELL DRILLERS LOG

MARSHALL
 ASI

6-29-74 date well completed

1974 Dem. Kent Gumpf well Marshall
 firm name county well located

LANDOWNER:

Clyde Bonds

description of formations encountered

clay
 sand

from 0 to 20

Mt. Pleasant miss.
 (mailing address)

20 165

WELL LOCATION:

sec. 36 T. 1 N. R. 4 E.
 5 miles west of Mt. Pleasant
 (distance) (direction) (nearest town)

WELL PURPOSE: Drilling
 (home, irrigation, municipal, industrial)

WELL COMPLETION DATA:

- (1) diameter (inches) 4"
- (2) total depth (feet) 165 feet
- (3) static water level (feet) 125 feet below top of ground.
- (4) casing pvc, 165 feet (material) (depth)
- (size) if telescope see back.
- (5) screen 7 ft., 158 feet (length) (depth to top)
- 4" gravel wall (size) (material)
- (6) pump 3/4 HP, 17 (yield gpm)
- (type power)
- (7) electric log elect. (yes or no)

CODED

(organization running log)

(8) how well bottom plugged 4" cof.


RECEIVED
 JUL 15 1974

DRILLERS REMARKS:

MISS. BD. OF WATER COMMISSIONERS

If well telescopes please sketch and show depths.

GROUND LEVEL

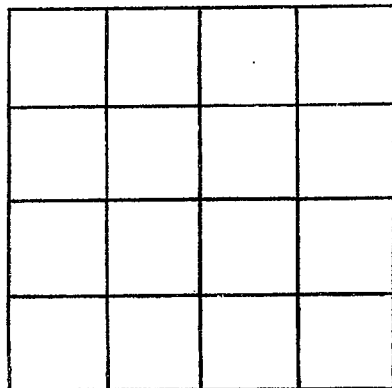

SECTION _____

Please indicate well location X.

ADDITIONAL INFORMATION

If more than one screen,
show locations of each on sketch.