

MARSHALL
A 52
5-28-74

MISSISSIPPI
 BOARD OF WATER COMMISSIONERS
 416 North State Street
 Jackson, Mississippi 39201

CODED

WATER WELL DRILLERS LOG

May 28 1974 R. L. Carpenter Marshall
 date well completed firm name county well located

LANDOWNER: A. E. Odain
 Cayer, Miss
 R. E. D
 (mailing address)

description of formations encountered	from	to
surface soil	0	18
red. white sand	18	32
white clay	32	50
white fine sand	50	83
white coarse sand	83	195

WELL LOCATION:

sec. 34 T-1 N R-4 E
 1/2 miles north of Cayer
 (distance) (direction) (nearest town)

WELL PURPOSE: Home
 (home, irrigation, municipal, industrial)

WELL COMPLETION DATA:

- (1) diameter (inches) 4
- (2) total depth (feet) 145
- (3) static water level (feet) 84 below above top of ground.
- (4) casing Plastic, 139 ft.
 (material) (depth)

_____ If telescope see back.
 (size)

- (5) screen 6 ft, 139 ft.
 (length) (depth to top)
 4 in, Plastic & gravel
 (size) (material)

- (6) pump 1/2 8
 (HP) (yield gpm)
 Elec.
 (type power)

- (7) electric log no
 (yes or no)

_____ (organization running log)

- (8) how well bottom plugged Plastic cap

CODED


RECEIVED
 OCT 4 1974

RS REMARKS:

MISS. BD. OF WATER COMMISSIONERS

If well telescopes please sketch and show depths.

GROUND LEVEL

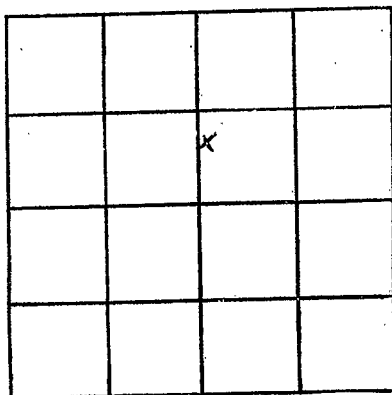

SECTION 34

Please indicate well location X.

ADDITIONAL INFORMATION

If more than one screen, show locations of each on sketch.