

MISSISSIPPI  
 BOARD OF WATER COMMISSIONERS  
 416 North State Street  
 Jackson, Mississippi 39201

CODED

WATER WELL DRILLERS LOG

MARSHALL  
 A53  
 7/17-74

July 17 19 74 R. L. Carpenter Marshall  
 date well completed firm name county well located

LANDOWNER: Edward L. Triffitt

Collierville, Tenn.

RFD

(mailing address)

WELL LOCATION:

sec. 22 T-1 N R-4 E  
 3 miles north of Cape  
 (distance) (direction) (nearest town)

WELL PURPOSE: Home  
 (home, irrigation, municipal, industrial)

WELL COMPLETION DATA:

- (1) diameter (inches) 4
- (2) total depth (feet) 127
- (3) static water level (feet) 70 below top of ground.
- (4) casing Plastic, 121 ft.  
 (material) (depth)

(size) if telescope see back.

- (5) screen 6 ft., 12 ft.  
 (length) (depth to top)  
 4 in. Plastic screened  
 (size) (material)

- (6) pump 1/2 8  
 (HP) (yield gpm)

Eber  
 (type power)

- (7) electric log No  
 (yes or no)

(organization running log)

- (8) how well bottom plugged Plastic cap

DRILLERS REMARKS:


description of formations encountered	from	to
surface soil	0	20
white fine sand & white clay	20	35
red white sand	35	80
white clay	80	93
white coarse sand	93	127

CODED

MISS. REG. NO. 3 6100000

If well telescopes please sketch and show depths.

GROUND LEVEL

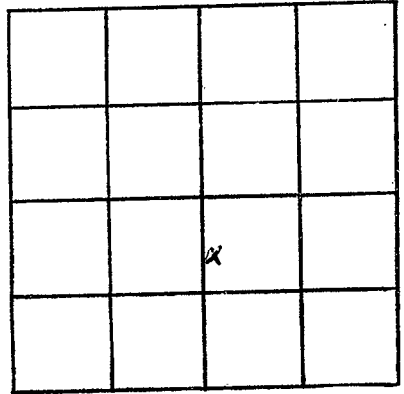

SECTION 22

Please indicate well location X.

ADDITIONAL INFORMATION

If more than one screen, show locations of each on sketch.