

MARSHALL
A 54
8-30-74

MISSISSIPPI
BOARD OF WATER COMMISSIONERS
416 North State Street
Jackson, Mississippi 39201

CODED

WATER WELL DRILLERS LOG

8-30 1974 date well completed
24 Bishop Bros. W.D. firm name
Marshall county well located

LANDOWNER: East Barton

description of formations encountered

from

to

Farms - College Ave.
Bally Springs, Miss.
(mailing address)

Red Clay & Shale	0	30
White, Sand, Gravel	30	45
White, Sand	45	140

WELL LOCATION:

sec 25 T 1 N R 5 E
1 miles E of Barton
(distance) (direction) (nearest town)

WELL PURPOSE: Home
(home, irrigation, municipal, industrial)

WELL COMPLETION DATA:

- (1) diameter (inches) 4 1/2
- (2) total depth (feet) 140
- (3) static water level (feet) 80 below top of ground
- (4) casing (material) Plastic, (depth) 140
If telescope see back. (size)
- (5) screen 4 1/2", 136 (length) (depth to top)
4 1/2", Gravel (size) (material)
- (6) pump 1/2 (HP) 10 (yield gpm)
Electric 230 (type power)
- (7) electric log No (yes or no)
- (organization running log)
- (8) how well bottom plugged Cap

CODED


RECEIVED
SEP 25 1974

DRILLERS REMARKS:

MISS. BD. OF WATER COMMISSIONERS

If well telescopes please sketch and show depths.

GROUND LEVEL

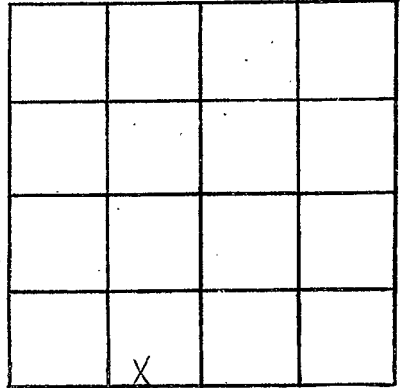

SECTION *25*

Please indicate well location X.

ADDITIONAL INFORMATION

If more than one screen,
show locations of each on sketch.