

**MARSHALL**  
**A55**  
**10/11/74**

MISSISSIPPI  
 BOARD OF WATER COMMISSIONERS  
 416 North State Street  
 Jackson, Mississippi 39201

**WATER WELL DRILLERS LOG**

10-11 1974 Bell Smith Well Drilling Marshall  
 date well completed firm name county well located

LANDOWNER: Purvis N. Lane  
Rt. 3 Box 168-76  
Collierville, Tenn. 38017  
 (mailing address)

WELL LOCATION:  
 sec. 30 T. 1 N. R. 4 E.  
1 miles east of Easton  
 (distance) (direction) (nearest town)

WELL PURPOSE:  
 (~~Home~~) Irrigation, municipal, industrial)

- WELL COMPLETION DATA:
- (1) diameter (inches) 4"
  - (2) total depth (feet) 165'
  - (3) static water level (feet) 80' below above top of ground.
  - (4) casing plastic, 165'  
 (material) (depth)  
 (size) If telescope see back.
  - (5) screen 4", 10'  
 (length) (depth to top)  
4", plastic  
 (size) (material)
  - (6) pump 1/2, 10  
 (HP) (yield gpm)  
electric  
 (type power)
  - (7) electric log no  
 (yes or no)
  - (8) how well bottom plugged plugged

description of fomations encountered	from to	
	from	to
<u>red clay</u>	<u>0'</u>	<u>10'</u>
<u>gravel &amp; sand</u>	<u>10'</u>	<u>30'</u>
<u>red sand</u>	<u>30'</u>	<u>80'</u>
<u>Clay</u>	<u>80'</u>	<u>160'</u>
<u>white sand</u>	<u>160'</u>	<u>165'</u>

CODED


RECEIVED  
 OCT 29 1974

DRILLERS REMARKS:

MISS. BD. OF WATER COMMISSIONERS

If well telescopes please sketch and show depths.

GROUND LEVEL

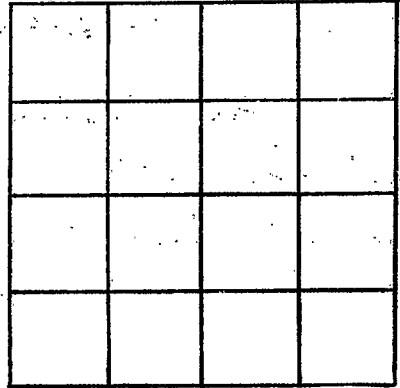

SECTION \_\_\_\_\_

Please indicate well location X.

ADDITIONAL INFORMATION

If more than one screen, show locations of each on sketch.