

MARSHALL
 A 57
 10-29-74

MISSISSIPPI
 BOARD OF WATER COMMISSIONERS
 416 North State Street
 Jackson, Mississippi 39201


CODED

WATER WELL DRILLERS LOG

10-24 1974 Bob Smith Well Drilling Marshall
 date well completed firm name county well located

LANDOWNER:	description of formations encountered	from	to
N. L. Stevenson 1660 Detwiler Rd.	Top soil	0'	15'
Memphis Tenn. 38111 (mailing address)	Brown sand & gravel	15'	40'
WELL LOCATION: sec 20 T 1 N R 4 E 1 miles east of Barton (distance) (direction) (nearest town)	White sand & clay	40'	100'
WELL PURPOSE: Home (home, irrigation, municipal, industrial)	White sand	100'	165'
WELL COMPLETION DATA: (1) diameter (inches) 4" (2) total depth (feet) 165' (3) static water level (feet) 80-100' below top of ground. (4) casing plastic, 10' (material) (depth) (size) If telescope see back. (5) screen 10, 155' (length) (depth to top) 4 plastic (size) (material) (6) pump 1/2 10 (HP) (yield gpm) electric (type power) (7) electric log no (yes or no) (organization running log) (8) how well bottom plugged plugged			
DRILLERS REMARKS:			

CODED

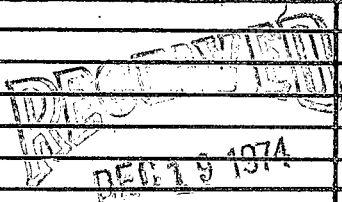

MISS. Bd. OF WATER COMMISSIONERS

If well telescopes please sketch and show depths.

GROUND LEVEL

		+	

SECTION _____

Please indicate well location X.

ADDITIONAL INFORMATION

If more than one screen, show locations of each on sketch.