

Marshall
A 58
6-6-75

MISSISSIPPI
BOARD OF WATER COMMISSIONERS
416 North State Street
Jackson, Mississippi 39201

WATER WELL DRILLERS LOG

~~August 6~~ 1975 Earl Jones Well Co. Marshall
 Date well completed Firm name county well located

LANDOWNER:
Ernest Weber
Collierville Tenn. RT.
(mailing address)
WELL LOCATION:
sec. 26 T 1 N R. 5 E 15E
S W
1/3 miles S of Barton
(distance) (direction) (nearest town)

description of formations encountered	from	to
clay & Topsoil	0	10
sand	10	60
clay	60	64
sand	64	122

WELL PURPOSE: Home
(home, irrigation, municipal, industrial)

WELL COMPLETION DATA:

(1) diameter (inches) 4"

(2) total depth (feet) 122

(3) static water level (feet) 70 below above top of ground.

(4) casing plastic 116
(material) (depth)
4" if telescope see back.
(size)

(5) screen 6' 116
(length) (depth to top)
4" plastic gravel
(size) (material)

(6) pump 1/2 20
(HP) (yield gpm)
Electric
(type power)

(7) electric log no
(yes or no)
(organization running log)

(8) how well bottom plugged
plastic cap

CODED


RECEIVED
JUN 11 1975

DRILLERS REMARKS:

MISS. BD. OF WATER COMMISSIONERS

If well telescopes please sketch and show depths.

GROUND LEVEL

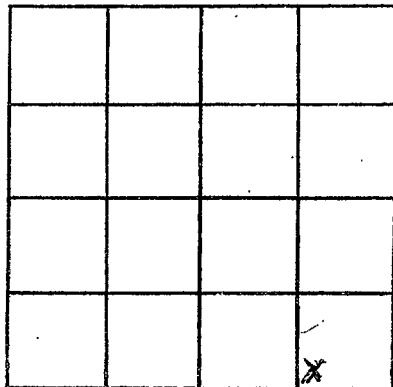

SECTION 26

Please indicate well location X.

ADDITIONAL INFORMATION

If more than one screen,
show locations of each on sketch.