

MARSHALL
A 59
10-23-70

MISSISSIPPI
 BOARD OF WATER COMMISSIONERS CODED
 416 North State Street
 Jackson, Mississippi 39201

WATER WELL DRILLERS LOG

10-23 1974 date well completed
 Bob Smith Well Drilling firm name
 Marshall county well located

LANDOWNER: <u>Walter H. Conwill</u>	description of formations encountered	from	to
<u>Rt. 3 Box 168-34</u> <u>Collinsville, Tenn. 38019</u> (mailing address)			
	<u>fine sand</u>	<u>30'</u>	<u>100'</u>
	<u>Course white sand</u>	<u>100'</u>	<u>165'</u>
WELL LOCATION: sec <u>20</u> T <u>1</u> N R <u>4</u> E <u>1</u> miles <u>east</u> of <u>Barton</u> (distance) (direction) (nearest town)			
WELL PURPOSE: <u>home</u> (home, irrigation, municipal, industrial)			
WELL COMPLETION DATA:			
(1) diameter (inches) <u>4</u>			
(2) total depth (feet) <u>165'</u>			
(3) static water level (feet) <u>80'</u> below top of ground.			
(4) casing <u>plastic</u> , <u>165'</u> (material) (depth)			
(size) if telescope see back.			
(5) screen <u>10"</u> , <u>155'</u> (length) (depth to top)			
<u>4"</u> , <u>plastic</u> (size) (material)			
(6) pump <u>1/2</u> , <u>10</u> (HP) (yield gpm)			
<u>electric</u> (type power)			
(7) electric log <u>no</u> (yes or no)			
(organization running log)			
(8) how well bottom plugged <u>plugged</u>			
DRILLERS REMARKS:			


CODED

RECEIVED
 MISSISSIPPI
 DEC 19 1974

MISS. BD. OF WATER COMMISSIONERS

If well telescopes please sketch and show depths.

GROUND LEVEL

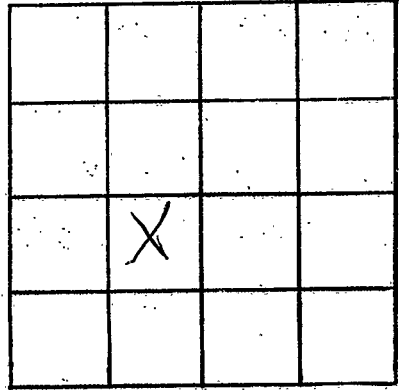

SECTION _____

Please indicate well location X.

ADDITIONAL INFORMATION

If more than one screen,
show locations of each on sketch.