

Marshall
A 61
5-9-75

MISSISSIPPI
BOARD OF WATER COMMISSIONERS
416 North State Street
Jackson, Mississippi 39201

CODED

WATER WELL DRILLERS LOG

May 9 1975 R. L. Carpenter Marshall
date well completed firm name county well located

LANDOWNER: Thomas Wood

Coyne, Miss

R.F.D.

(mailing address)

WELL LOCATION:

sec. 35 T 2 N R 4 E 15E
2 miles East of Coyne
(distance) (direction) (nearest town)

WELL PURPOSE:

Home
(home, irrigation, municipal, industrial)

WELL COMPLETION DATA:

- (1) diameter (inches) 4
- (2) total depth (feet) 145
- (3) static water level (feet) 50 below top of ground.
- (4) casing Plastic, 139' (material) (depth)

If telescope see back.
(size)

- (5) screen 6' 139' (length) (depth to top)

4" Plastic (size) (material)

- (6) pump 3/4 10 (HP) (yield gpm)

Elec. (type power)

- (7) electric log No (yes or no)

(organization running log)

- (8) how well bottom plugged Plastic cap

DRILLERS REMARKS:


description of formations encountered	from	to
surface soil	0	12
red brown sand	12	20
med. white sand	20	63
white fine sand	63	98
white CODED	98	104
white coarse sand	104	145

RECEIVED
JUL 22 1975

MISS. BD. OF WATER COMMISSIONERS

If well telescopes please sketch and show depths.

GROUND LEVEL

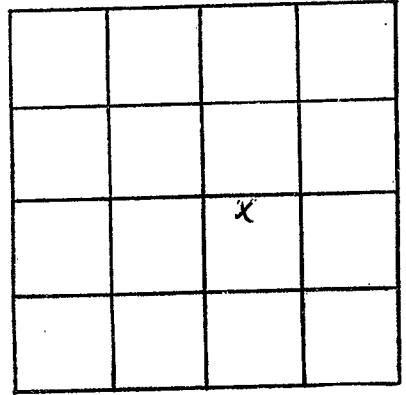

SECTION 32

Please indicate well location X.

ADDITIONAL INFORMATION

If more than one screen,
show locations of each on sketch.