

MARSHALL
A6Z

MISSISSIPPI DEPARTMENT OF NATURAL RESOURCES
Bureau of Land and Water Resources
Southport Mall
P.O. Box 10631
Jackson, Mississippi 39209
WATER WELL DRILLERS LOG

CODED
CODED

6-19-86 19 Wilson Well Co. Inc. Marshall
date well completed firm name county well located

LANDOWNER: Joe Matidonio
Mt Pleasant, Mo.
(mailing address)

description of formations encountered	from	to
<u>Red Clay + Brown Clay</u>	<u>0</u>	<u>15</u>
<u>Red Sand</u>	<u>15</u>	<u>60</u>
<u>White Sand</u>	<u>60</u>	<u>105</u>
<u>White clay</u>	<u>105</u>	<u>110</u>
<u>White Sand</u>	<u>110</u>	<u>KRS</u>

WELL LOCATION:
sec. 25 T 1 N R 4 E
4 miles W of Mt Pleasant
(distance) (direction) (nearest town)

WELL PURPOSE:
(home, irrigation, municipal, industrial)

- WELL COMPLETION DATA:
- (1) diameter (inches) 4
 - (2) total depth (feet) 195
 - (3) static water level (feet) _____ below above top of ground.
 - (4) casing PVC, 175,
(material) (depth)
4 if telescope see back.
(size)
 - (5) screen 20, 175
(length) (depth to top)
4, PVC
(size) (material)
 - (6) pump 5 50
(HP) (yield gpm)
elect.
(type power)
 - (7) electric log NO
(yes or no)
(organization running log)
 - (8) how well bottom plugged PVC Cap

CHART

CODED


RECEIVED
JUL 8 1986

Department of Natural Resources
Bureau of Land and Water Resources

DRILLERS REMARKS:

If well telescopes please sketch and show depths.

GROUND LEVEL

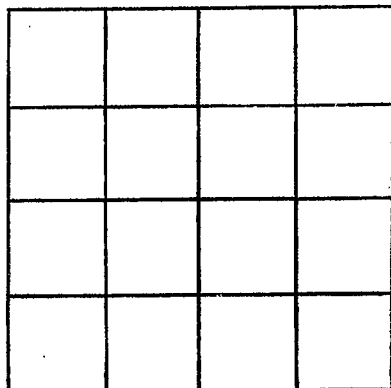

SECTION _____

Please indicate well location X.

ADDITIONAL INFORMATION

If more than one screen, show locations of each on sketch.