

MARSHALL
A 2004
11-11-76

MISSISSIPPI
 BOARD OF WATER COMMISSIONERS
 416 North State Street
 Jackson, Mississippi 39201

WATER WELL DRILLERS LOG

11-11- 76 W.A. Mason Marshall
 date well completed firm name county well located

LANDOWNER:
Len Cox
RFD. Collierville Tenn
 (mailing address)

description of formations encountered	from	to
Clay Lora	40	8
gracep	8	20
red sand	20	60
white sand	60	168

WELL LOCATION:
 sec 25 T 1 N R 5 E
1/2 miles East of Benton
 (distance) (direction) (nearest town)

WELL PURPOSE: Home
 (home, irrigation, municipal, industrial)

- WELL COMPLETION DATA:
- (1) diameter (inches) 4"
 - (2) total depth (feet) 168'
 - (3) static water level (feet) 72' below top of ground.
 - (4) casing Plastic 158'
 (material) (depth)
4" if telescope see back.
 (size)
 - (5) screen 10 158'
 (length) (depth to top)
4" Plastic
 (size) (material)
 - (6) pump 1 15
 (HP) (yield gpm)
electric
 (type power)
 - (7) electric log No
 (yes or no)
- (organization running log)
- (8) how well bottom plugged Cap


DRILLERS REMARKS:

RECEIVED
 JUL 7 - 1977

MISS. Bd. OF WATER COMMISSIONERS

If well telescopes please sketch and show depths.

GROUND LEVEL

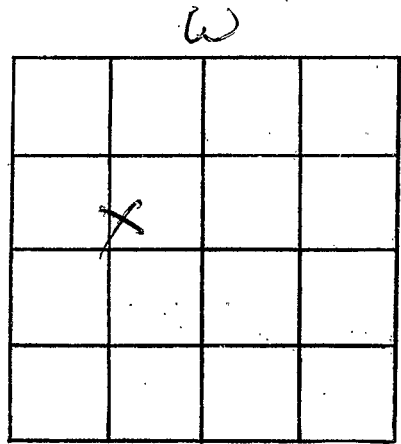

SECTION E 25

Please indicate well location X.

ADDITIONAL INFORMATION

If more than one screen, show locations of each on sketch.