

MARSHALL
 A 2005
 2-11-77

MISSISSIPPI
 BOARD OF WATER COMMISSIONERS
 416 North State Street
 Jackson, Mississippi 39201

WATER WELL DRILLERS LOG

2-11-77 date well completed
 W.A. Mason firm name
 16R Water World Cont. Marshall county well located

LANDOWNER:

Hukkie Nelson Jr.
 P.O. Calloway Lane
 (mailing address)

description of formations encountered

from to

Clay Silt	80	8
Red clay	8	30
Red sand	30	40
white sand	40	104
white clay	104	135
white sand	135	166

WELL LOCATION:

sec 26 T-1 N R-5 E
 3/4 miles NW of Barton
 (distance) (direction) (nearest town)

WELL PURPOSE: Home
 (home, irrigation, municipal, industrial)

WELL COMPLETION DATA:

- (1) diameter (inches) 4 1/4
- (2) total depth (feet) 156 1
- (3) static water level (feet) 85 below top of ground.
- (4) casing Plastic, 156 1
 (material) (depth)
4 1/4 if telescope see back.
 (size)
- (5) screen 10', 10'
 (length) (depth to top)
4 1/4 Plastic
 (size) (material)
- (6) pump 3/4 10
 (HP) (yield gpm)
Electric
 (type power)
- (7) electric log No
 (yes or no)
 (organization running log)
- (8) how well bottom plugged Cap


RECEIVED
 JUL 7 - 1977

MISS. BD. OF WATER COMMISSIONERS

DRILLERS REMARKS:

If well telescopes please sketch and show depths.

GROUND LEVEL

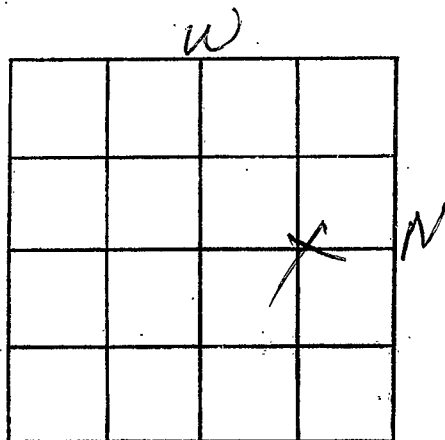

SECTION 26

Please indicate well location X.

ADDITIONAL INFORMATION

If more than one screen, show locations of each on sketch.