

MARSHALL  
 A 2009  
 5/1/78

MISSISSIPPI  
 BOARD OF WATER COMMISSIONERS  
 416 North State Street  
 Jackson, Mississippi 39201

WATER WELL DRILLERS LOG

5/1/78 1978 Leide Well Co Marshall  
 date well completed firm name county well located

LANDOWNER:  
 Bill Tedford Farmer  
 Collierville, Tenn  
 (mailing address)

description of formations encountered	from	to
Surface Clay	0	16
Sand + gravel	16	50
Sand + Clay	50	110
Coarse Sand	110	138

WELL LOCATION:  
 sec. 22 T N R 4 W  
 S E W  
 2 miles N of Cape  
 (distance) (direction) (nearest town)

WELL PURPOSE: Home  
 (home, irrigation, municipal, industrial)

WELL COMPLETION DATA:

(1) diameter (inches) 4

(2) total depth (feet) 138

(3) static water level (feet) 71 below top of ground.

(4) casing PVC, 138 (material) (depth)  
 4 (size) if telescope see back.

(5) screen 10, 138 (length) (depth to top)  
 4 (size) PVC (material)

(6) pump 1/2 (HP) 15 (yield gpm)  
 Elec (type power)

(7) electric log (yes or no)

(organization running log)

(8) how well bottom plugged PVC cap


RECEIVED  
 JUN 20 1978

MISS. BD. OF WATER COM.

DRILLERS REMARKS:

If well telescopes please  
sketch and show depths.

GROUND LEVEL

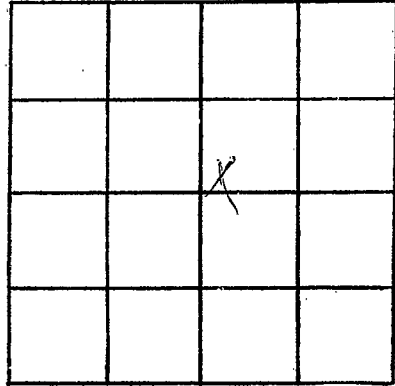

SECTION 20

Please indicate well location X.

ADDITIONAL INFORMATION

If more than one screen,  
show locations of each on sketch.