

MARSHALL

A 210

10-18-78

MISSISSIPPI BOARD OF WATER COMMISSIONERS  
416 North State Street  
Jackson, Mississippi 39201

WATER WELL DRILLERS LOG

10-18-78 date well completed  
Hick Well Co firm name  
Marshall county well located

LANDOWNER: Mavis Mc Leo

description of formations encountered

from to

Pl. 3  
Byhalia, Ms.  
(mailing address)

<u>Red Clay</u>	<u>0</u>	<u>15</u>
<u>White Sand + Clay</u>	<u>15</u>	<u>75</u>
<u>White Sand + Black Clay</u>	<u>75</u>	<u>135</u>
<u>White Sand</u>	<u>135</u>	<u>195</u>

WELL LOCATION:

sec 23 T 1 N R 5 E  
2 miles N of Barton  
(distance) (direction) (nearest town)

WELL PURPOSE: Home  
(home, irrigation, municipal, industrial)


WELL COMPLETION DATA:

- (1) diameter (inches) 4
- (2) total depth (feet) 195
- (3) static water level (feet) 80 below top of ground.
- (4) casing PVC, 195,  
(material) (depth)  
if telescope see back.
- (5) screen 7', 188  
(length) (depth to top)  
4", ground type  
(size) (material)
- (6) pump 3/4, 10  
(HP) (yield gpm)  
220V  
(type power)
- (7) electric log No  
(yes or no)

(organization running log)

(8) how well bottom plugged Cap


DRILLERS REMARKS:

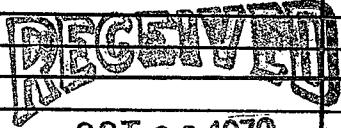

OCT 20 1978

If well telescopes please sketch and show depths.

GROUND LEVEL

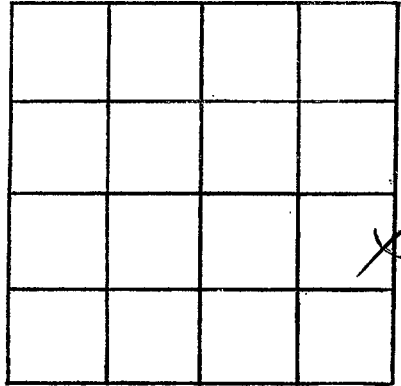

SECTION 23

Please indicate well location X.

ADDITIONAL INFORMATION

If more than one screen,  
show locations of each on sketch.