

MARSHALL
 A 2011
 7-2-79

MISSISSIPPI
 BOARD OF WATER COMMISSIONERS
 416 North State Street
 Jackson, Mississippi 39201

WATER WELL DRILLERS LOG

7-2-79 date well completed
 1979 Deant Kent Bumpers, Ed. firm name
 Marshall county well located

LANDOWNER:	description of formations encountered	from	to
(mailing address)			
C.O. Wright	Clay	0	20
Mt Pleasant, Miss	Sand	20	125
WELL LOCATION:	Clay	125	135
sec. 23 T 1 N R 4 E	Sand	135	150
8 miles west of Mt Pleasant			
(distance) (direction) (nearest town)			
WELL PURPOSE: Dwelling			
(home, irrigation, municipal, industrial)			
WELL COMPLETION DATA:			
(1) diameter (inches) 4"			
(2) total depth (feet) 150 feet			
(3) static water level (feet) 20 below top of ground.			
(4) casing PVC, 150 feet (material) (depth)			
(size) If telescope see back.			
(5) screen 24 ft, 143 feet (length) (depth to top)			
4" Gravel wad (size) (material)			
(6) pump 3/4 HP, 14 (yield gpm)			
(type power)			
(7) electric log Gled. (yes or no)			
(organization running log)			
(8) how well bottom plugged 4" CB			
DRILLERS REMARKS:			


Miss. Board of Water Comm.

AUG 8 1979

RECEIVED

If well telescopes please sketch and show depths.

GROUND LEVEL

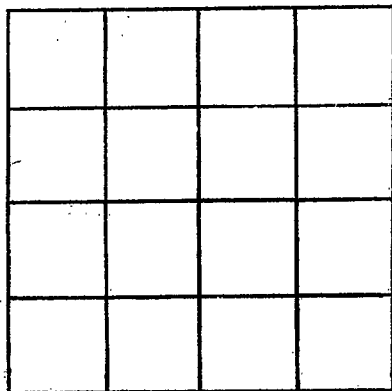

SECTION _____

Please indicate well location X.

ADDITIONAL INFORMATION

If more than one screen,
show locations of each on sketch.