

Marshall
A 2012
8-14-79

MISSISSIPPI
BOARD OF WATER COMMISSIONERS
416 North State Street
Jackson, Mississippi 39201

WATER WELL DRILLERS LOG

8-14 date well completed
29 Dean Kent Superwell firm name
Marshall county well located

LANDOWNER:	description of formations encountered	from	to
Bill Smith			
B. Phillips, Inc. (mailing address)	Sand	30	140
WELL LOCATION:			
sec. 35 (1 N 5 W) R. 5 E			
2 miles NORTH of Boston (distance) (direction) (nearest town)			
WELL PURPOSE: Drilling (home, irrigation, municipal, industrial)			
WELL COMPLETION DATA:			
(1) diameter (inches) 4"			
(2) total depth (feet) 140 feet			
(3) static water level (feet) 80 below top of ground.			
(4) casing PVC 140 feet (material) (depth)			
(size) If telescope see back.			
(5) screen 7 ft. 133 feet (length) (depth to top)			
4" gravel wall (size) (material)			
(6) pump 3/4 HP 14 (HP) (yield/gpm)			
(type power)			
(7) electric log elect. (yes or no)			
(organization running log)			
(8) how well bottom plugged 4" cap.			
DRILLERS REMARKS:			

DEPT. OF NATURAL RESOURCES
BUREAU OF LAND & WATER RESOURCES

OCT 5 1979

RECEIVED


DEPT. OF NATURAL RESOURCES
BUREAU OF LAND & WATER RESOURCES

OCT 5 1979

RECEIVED

If well telescopes please sketch and show depths.

GROUND LEVEL

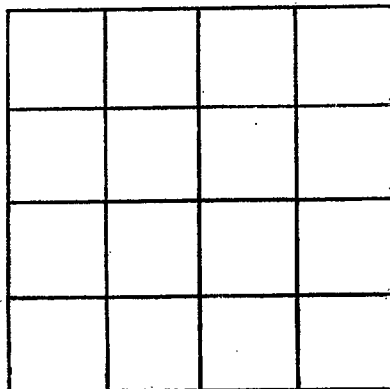

SECTION _____

Please indicate well location X.

ADDITIONAL INFORMATION

If more than one screen,
show locations of each on sketch.