

MARSHALL

A 2013

6-2-78

June 2 1978 date well completed

MISSISSIPPI
BOARD OF WATER COMMISSIONERS
416 North State Street
Jackson, Mississippi 39201

WATER WELL DRILLERS LOG

R. L. Carpenter firm name

Marshall county well located

LANDOWNER: John Udair

Collinsville, Tenn.

RFD

(mailing address)

WELL LOCATION:

sec. 30 T-1 N R-4 E
 (S) (N)
 1 miles NE of Baxter
 (distance) (direction) (nearest town)

WELL PURPOSE: None
(home, irrigation, municipal, industrial)

WELL COMPLETION DATA:

- (1) diameter (inches) 4
- (2) total depth (feet) 127
- (3) static water level (feet) 95 below top of ground.
- (4) casing Plastic 117' (material) (depth)
 (size) If telescope see back.
- (5) screen 18' 117' (length) (depth to top)
 2" Plastic (size) (material)
- (6) pump 3/4 10 (HP) (yield gpm)
 Elec (type power)
- (7) electric log No (yes or no)
 (organization running log)
- (8) how well bottom plugged PVC cap

| description of formations encountered | from | to |
|---------------------------------------|------|-----|
| Surface Soil | 0 | 22 |
| Med & Coarse White Sand | 22 | 60 |
| White Clay | 60 | 78 |
| Med White Sand | 78 | 98 |
| White Coarse Sand | 98 | 127 |
| | | |
| | | |
DEPT. OF NATURAL RESOURCES BUREAU OF LAND & WATER RESOURCES


JUL 28 1980

RECEIVED

DRILLERS REMARKS:

If well telescopes please
sketch and show depths.

GROUND LEVEL

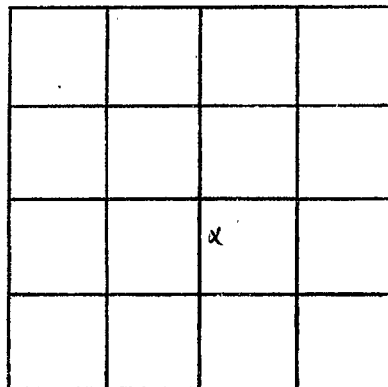

SECTION 36

Please indicate well location X.

ADDITIONAL INFORMATION

A series of horizontal lines for writing additional information, starting below the 'ADDITIONAL INFORMATION' header and extending to the bottom of the page.

If more than one screen,
show locations of each on sketch.