

Marshall  
 A 2014  
 7-10-78

MISSISSIPPI  
 BOARD OF WATER COMMISSIONERS  
 416 North State Street  
 Jackson, Mississippi 39201

WATER WELL DRILLERS LOG

July 10 1978 R. L. Carpenter Marshall  
 date/well completed firm name county well located

LANDOWNER: *Nick Vance*  
*Colbernville, Tenn*

RFD  
 (mailing address)

WELL LOCATION:

sec. 36 T 1 N R 5 E  
 1 miles SE of Barton  
 (distance) (direction) (nearest town)

WELL PURPOSE: *None*  
 (home, irrigation, municipal, industrial)

WELL COMPLETION DATA:

- (1) diameter (inches) *4*
- (2) total depth (feet) *133*
- (3) static water level (feet) *80* below above top of ground.
- (4) casing *Plastic*, *123*  
 (material) (depth)  
 (size) If telescope see back.
- (5) screen *10'*, *123'*  
 (length) (depth to top)  
*4"*, *Plastic*  
 (size) (material)
- (6) pump *1/2*, *8*  
 (HP) (yield gpm)  
*Elec*  
 (type power)
- (7) electric log *No*  
 (yes or no)
- (organization running log)
- (8) how well bottom plugged *PVC cap*

description of formations encountered	from	to
<i>Surface Soil</i>	<i>0</i>	<i>12</i>
<i>Red coarse sand</i>	<i>12</i>	<i>30</i>
<i>Red Clay</i>	<i>30</i>	<i>48</i>
<i>white fine sand</i>	<i>48</i>	<i>75</i>
<i>white clay</i>	<i>75</i>	<i>110</i>
<i>white coarse sand</i>	<i>110</i>	<i>133</i>

DRILLERS REMARKS:


DEPT. OF NATURAL RESOURCES  
 BUREAU OF LAND & WATER RESOURCES

APR 24 1981

RECEIVED

If well telescopes please sketch and show depths.

GROUND LEVEL

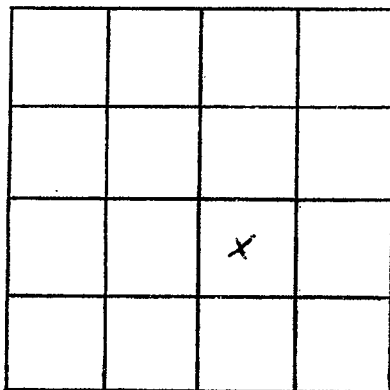

SECTION 36

Please indicate well location X.

ADDITIONAL INFORMATION

If more than one screen,  
show locations of each on sketch.