

MARSHALL  
A 2015  
10-27-78

MISSISSIPPI  
 BOARD OF WATER COMMISSIONERS  
 416 North State Street  
 Jackson, Mississippi 39201

WATER WELL DRILLERS LOG

Oct 27 19 78 R. L. Carpenter Marshall  
 date well completed firm name county well located

LANDOWNER: <u>Mr. Clinton Hudson</u>	description of formations encountered		from	to
<u>Collierville, Tenn.</u>	<u>Surface Soil</u>		<u>0</u>	<u>20</u>
<u>RFD</u> (mailing address)	<u>med. Red Sand</u>		<u>20</u>	<u>42</u>
<b>WELL LOCATION:</b>	<u>med white sand</u>		<u>42</u>	<u>80</u>
sec. <u>24</u> T. <u>1</u> N. R. <u>4</u> E.	<u>White Clay</u>		<u>80</u>	<u>105</u>
<u>3</u> miles <u>West</u> of <u>Mt. Pleasant</u>	<u>White coarse sand</u>		<u>105</u>	<u>145</u>
(distance) (direction) (nearest town)				
<b>WELL PURPOSE:</b> <u>Home</u>				
(home, irrigation, municipal, industrial)				
<b>WELL COMPLETION DATA:</b>				
(1) diameter (inches) <u>4</u>				
(2) total depth (feet) <u>145</u>				
(3) static water level (feet) <u>96</u> below top of ground.				
(4) casing <u>Plaster</u> , <u>135'</u>				
(material) (depth)				
(size) if telescope see back.				
(5) screen <u>10'</u> , <u>135'</u>				
(length) (depth to top)				
<u>4"</u> , <u>Plaster</u>				
(size) (material)				
(6) pump <u>3/4</u> <u>12</u>				
(HP) (yield gpm)				
<u>Elec.</u>				
(type power)				
(7) electric log <u>No</u>				
(yes or no)				
(organization running log)				
(8) how well bottom plugged <u>PVC cap</u>				
DRILLERS REMARKS:				


DEPT. OF NATURAL RESOURCES  
 BUREAU OF LAND & WATER RESOURCES

ADD 30 001

RECEIVED

If well telescopes please sketch and show depths.

GROUND LEVEL

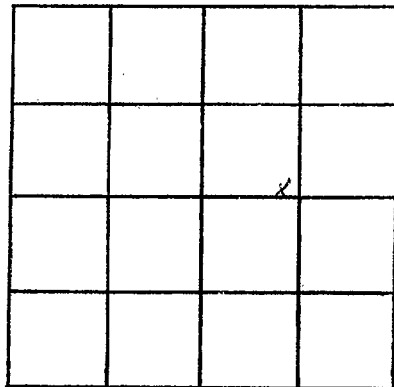

SECTION 24

Please indicate well location X.

ADDITIONAL INFORMATION

If more than one screen,  
show locations of each on sketch.