

MARSHALL
A 2016
6/6/79

MISSISSIPPI
BOARD OF WATER COMMISSIONERS
416 North State Street
Jackson, Mississippi 39201

WATER WELL DRILLERS LOG

June 6 1979 R. L. Carpenter Marshall
date well completed firm name county well located

LANDOWNER: Roger Johnston
Collierville, Tenn
RFD
(mailing address)

description of formations encountered	from	to
Surface Soil	0	18
red s. coarse Red Sand	18	40
red white Sand	40	84
white clay fine Sand	84	110
white coarse red Sand mixed	110	137

WELL LOCATION:
sec. 30 T. 1 N R. 4 E
1 1/2 miles N W of Barton
(distance) (direction) (nearest town)

WELL PURPOSE: Tray Water
(home, irrigation, municipal, industrial)

- WELL COMPLETION DATA:
- (1) diameter (inches) 4
 - (2) total depth (feet) 137
 - (3) static water level (feet) 92 below above top of ground.
 - (4) casing Plastic, 127',
(material) (depth)
(size) If telescope see back.
 - (5) screen 18', 127'
(length) (depth to top)
4", Plastic
(size) (material)
 - (6) pump 1 20
(HP) (yield gpm)
Elec.
(type power)
 - (7) electric log No.
(yes or no)
(organization running log)
 - (8) how well bottom plugged PVC caps


DRILLERS REMARKS:

DEPT. OF NATURAL RESOURCES
BUREAU OF LAND & WATER RESOURCES

MAY 18 1981
RECEIVED

If well telescopes please
sketch and show depths.

GROUND LEVEL

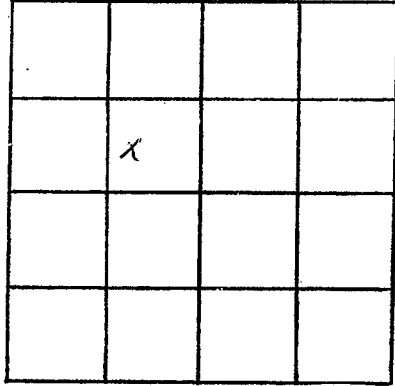

SECTION 30

Please indicate well location X.

ADDITIONAL INFORMATION

If more than one screen,
show locations of each on sketch.