

Marshall
A 2018

MISSISSIPPI
BOARD OF WATER COMMISSIONERS
416 North State Street
Jackson, Mississippi 39201

WATER WELL DRILLERS LOG

6/8/80

June 8 1980

R. L. Carpenter

Marshall

date well completed

firm name

county well located

LANDOWNER: Tommy Embanks

Callierville, Tenn

RFD

(mailing address)

description of formations encountered

from

to

Surface Soil

0

20

Med. & coarse Red Soil

20

45

med white sand

45

86

white clay & fine sand

86

115

white coarse sand

115

135

WELL LOCATION:

sec. 30 T. 1 S. R. 4 E.
2 miles East of Barton
(distance) (direction) (nearest town)

WELL PURPOSE: Home
(home, irrigation, municipal, industrial)

WELL COMPLETION DATA:

(1) diameter (inches) 4

(2) total depth (feet) 135

(3) static water level (feet) 85 below top of ground.

(4) casing PVC, 125'
(material) (depth)

(size) if telescope see back.

(5) screen 18', 125'
(length) (depth to top)

4", PVC
(size) (material)

(6) pump 1/2, 10
(HP) (yield gpm)

Elec.
(type power)

(7) electric log no
(yes or no)

(organization running log)

(8) how well bottom plugged Pvc Cap

DRILLERS REMARKS:


DEPT. OF NATURAL RESOURCES
BUREAU OF LAND & WATER RESOURCES

MAY 19 1981

RECEIVED

If well telescopes please sketch and show depths.

GROUND LEVEL

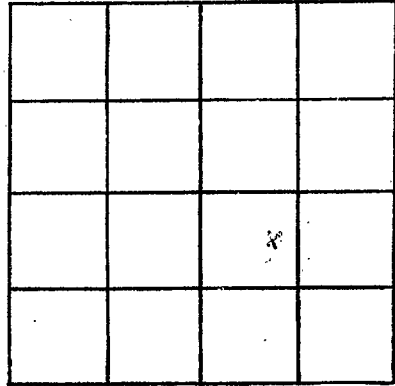

SECTION 30

Please indicate well location X.

ADDITIONAL INFORMATION

If more than one screen, show locations of each on sketch.