

MARSHALL  
 A 2019  
 7/30/80

MISSISSIPPI  
 BOARD OF WATER COMMISSIONERS  
 416 North State Street  
 Jackson, Mississippi 39201

WATER WELL DRILLERS LOG

7/30/80 19 B. Smith Well Sec. Marshall  
 date well completed firm name county well located

LANDOWNER:


A. J. Magers  
Barton, Miss.  
 (mailing address)

description of formations encountered

from to

top soil	0	5
red clay	5	60
white clay	60	80
white sand	80	145

WELL LOCATION:

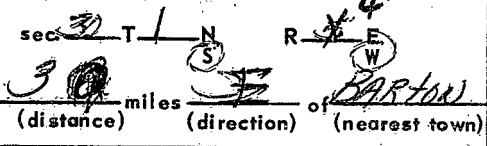

WELL PURPOSE:

(home, irrigation, municipal, industrial)

WELL COMPLETION DATA:

- (1) diameter (inches) 4"
- (2) total depth (feet) 145'
- (3) static water level (feet) 90' below top of ground.
- (4) casing plastic, 145' (material) (depth)
- (size) if telescope see back.
- (5) screen 20', 145' (length) (depth to top)
- 4", plastic (size) (material)
- (6) pump 3/4, 10 (HP) (yield gpm)
- elec. (type power)
- (7) electric log (yes or no)
- (organization running log)
- (8) how well bottom plugged cap

DEPT. OF NATURAL RESOURCES  
 BUREAU OF LAND & WATER RESOURCES


OCT 15 1980

RECEIVED

DRILLERS REMARKS:

If well telescopes please sketch and show depths.

GROUND LEVEL

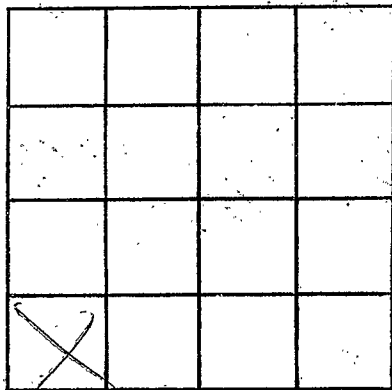

SECTION \_\_\_\_\_

Please indicate well location X.

ADDITIONAL INFORMATION

If more than one screen,  
show locations of each on sketch.