

MISSISSIPPI DEPARTMENT OF NATURAL RESOURCES

Bureau of Land and Water Resources

Southport Mall

P.O. Box 10631

Jackson, Mississippi 39209

WATER WELL DRILLERS LOG

Marshall
A 2021

Marshall

9-3-1980 Widron Well Co. date well completed firm name county well located

LANDOWNER:

Mrs. Sara Boone
8994 Center Hill Rd
Columbia, Mo.
 (mailing address)

description of formations encountered

from to

<u>Red Clay + Gravel</u>	<u>0</u>	<u>30</u>
<u>Red Sand</u>	<u>30</u>	<u>60</u>
<u>4</u>	<u>60</u>	<u>141</u>

WELL LOCATION:

sec. 20 T N R 4E
4 miles East of Columbia
 (distance) (direction) (nearest town)

WELL PURPOSE:

(home, irrigation, municipal, industrial)

WELL COMPLETION DATA:

- (1) diameter (inches) 4
- (2) total depth (feet) 145
- (3) static water level (feet) 110 below top of ground.
- (4) casing PVC 135
 (material) (depth)
- (size) if telescope see back.
- (5) screen 10 135
 (length) (depth to top)
- (size) gravel packed (material)
- (6) pump 3/4 10
 (HP) (yield gpm)
- electric
 (type power)
- (7) electric log (yes or no)

(organization running log)

- (8) how well bottom plugged 4"
plastic cap

DRILLERS REMARKS:


DEPT. OF NATURAL RESOURCES
 BUREAU OF LAND & WATER RESOURCES

SEP 29 1980

RECEIVED

If well telescopes please sketch and show depths.

GROUND LEVEL

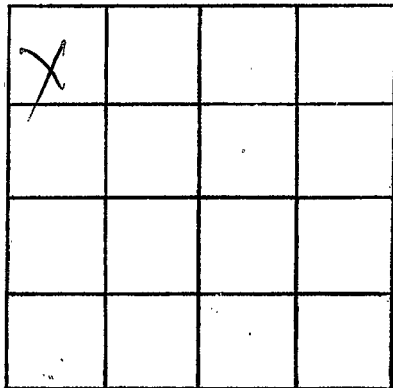

SECTION 20

Please indicate well location X.

ADDITIONAL INFORMATION

If more than one screen, show locations of each on sketch.