

MISSISSIPPI DEPARTMENT OF NATURAL RESOURCES

Bureau of Land and Water Resources

Southport Mall

P.O. Box 10631

Jackson, Mississippi 39209

WATER WELL DRILLERS LOG

Marshall
A 2002
4/28/81

4-28-81
date well completed

Wilson Well Co
firm name

Marshall
county well located

LANDOWNER:

J W Ramage
PO Box 412
Cullerville TN
(mailing address)

description of formations encountered

	from	to
Blue clay Red sand	0	30
White sand	30	60
White sand white clay white sand	60	90
White sand	90	135

WELL LOCATION:

sec. 13 T-1 N R-4 E
H miles SE of Cullerville
(distance) (direction) (nearest town)

WELL PURPOSE:

Home
(home, irrigation, municipal, industrial)

WELL COMPLETION DATA:

- (1) diameter (inches) 4
- (2) total depth (feet) 135'
- (3) static water level (feet) 100 below above top of ground.
- (4) casing plastic (material), (depth),
4" if telescope see back. (size)
- (5) screen 10' (length), (depth to top)
4" (size), plastic (material)
- (6) pump 1 (HP), 13 (yield gpm)
electric (type power)
- (7) electric log NO (yes or no)

(organization running log)


(8) how well bottom plugged plastic cap 4"

DRILLERS REMARKS:



If well telescopes please sketch and show depths.

GROUND LEVEL

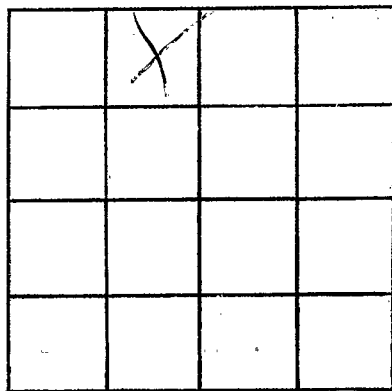

SECTION _____

Please indicate well location X.

ADDITIONAL INFORMATION

If more than one screen,
show locations of each on sketch.