

Marshall
A
2023

MISSISSIPPI
BOARD OF WATER COMMISSIONERS
416 North State Street
Jackson, Mississippi 39201

WATER WELL DRILLERS LOG

7-31-80 date well completed
Bob Smith & Sons firm name
Marshall county well located

LANDOWNER:	description of formations encountered	from	to
C. J. Meyer	top soil	0	5
Barton, Ms.	red clay	5	50
(mailing address)	gravel	50	80
	white sand	80	145

WELL LOCATION:

sec. 30 T-1 N R-4 E
S W
4 miles EAST of Barton
(distance) (direction) (nearest town)

WELL PURPOSE:

(home, irrigation, municipal, industrial)

WELL COMPLETION DATA:

- (1) diameter (inches) 4 1/2
- (2) total depth (feet) 145
- (3) static water level (feet) 89' below top of ground.
- (4) casing plastic 145' (material) (depth)
- (size) if telescope see back.
- (5) screen 10" 135' (length) (depth to top)
- 4" plastic (size) (material)
- (6) pump 3/4 12 (HP) (yield gpm)
- elec. (type power)
- (7) electric log (yes or no)
- (organization running log)
- (8) how well bottom plugged cap

DRILLERS REMARKS:


DEPT. OF NATURAL RESOURCES
BUREAU OF LAND & WATER RESOURCES

JUN 15 1982

RECEIVED

If well telescopes please
sketch and show depths.

GROUND LEVEL

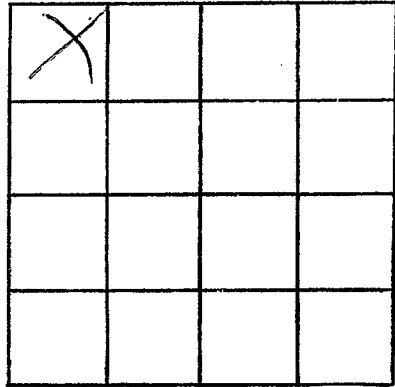

SECTION _____

Please indicate well location X.

ADDITIONAL INFORMATION

If more than one screen,
show locations of each on sketch.