

MISSISSIPPI DEPARTMENT OF NATURAL RESOURCES

Bureau of Land and Water Resources

Southport Mall

P.O. Box 10631

Jackson, Mississippi 39209

WATER WELL DRILLERS LOG

Marshall
A
2024

7-27-80 date well completed      Bob Smith firm name      Marshall county well located

LANDOWNER:	description of formations encountered	from	to
Dagers A.S. Lorton M. (mailing address)			
	red clay	5	60
	gravel	60	95
	white sand	95	150
<b>WELL LOCATION:</b>			
sec. 30 T. 1 N. R. 4 E. S. 4 W.			
4 miles East of Lorton (distance) (direction) (nearest town)			
<b>WELL PURPOSE:</b> (home, irrigation, municipal, industrial)			
<b>WELL COMPLETION DATA:</b>			
(1) diameter (inches) 4 1/2			
(2) total depth (feet) 150'			
(3) static water level (feet) 85' below top of ground			
(4) casing plastic 150' (material) (depth)			
_____ if telescope see back. (size)			
(5) screen 10' (length) 4 1/2' (depth to top)			
4" (size) plastic (material)			
(6) pump 2 1/2 (HP) 15 (yield gpm)			
elec. (type power)			
(7) electric log (yes or no) <input checked="" type="radio"/>			
_____ (organization running log)			
(8) how well bottom plugged cap			
<b>DRILLERS REMARKS:</b>			


DEPT. OF NATURAL RESOURCES  
BUREAU OF LAND & WATER RESOURCES

OCT 19 1982

RECEIVED

If well telescopes please sketch and show depths.

GROUND LEVEL

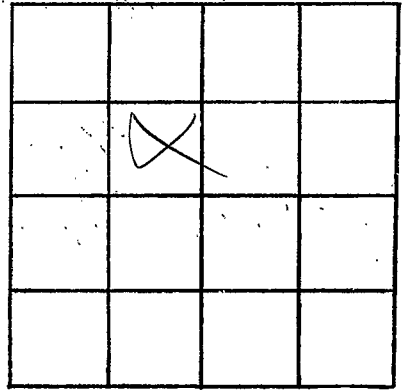

SECTION \_\_\_\_\_

Please indicate well location X.

ADDITIONAL INFORMATION

If more than one screen, show locations of each on sketch.