

MISSISSIPPI DEPARTMENT OF NATURAL RESOURCES

Bureau of Land and Water Resources

Southport Mall

P.O. Box 10631

Jackson, Mississippi 39209

WATER WELL DRILLERS LOG

Marshall
A
2025

7-31-80 1980 Blue Mill Marshall firm name county well located

LANDOWNER:	description of formations encountered	from	to
		<u>A. J. Rogers</u> <u>Clinton Ms.</u> (mailing address)	<u>top soil</u> <u>red clay</u> <u>gravel</u> <u>white sand</u>
<b>WELL LOCATION:</b>			
sec. <u>30</u> T. <u>1</u> N. R. <u>4</u> E. S. <u>5</u> W. <u>2</u> miles <u>West</u> of <u>Clinton</u> (distance) (direction) (nearest town)			
<b>WELL PURPOSE:</b> (home, irrigation, municipal, industrial)			
<b>WELL COMPLETION DATA:</b>			
(1) diameter (inches) <u>4"</u>			
(2) total depth (feet) <u>145'</u>			
(3) static water level (feet) <u>89'</u> below above top of ground.			
(4) casing <u>plastic</u> <u>145'</u> (material) (depth)			
_____ If telescope see back. (size)			
(5) screen <u>10'</u> <u>135'</u> (length) (depth to top)			
<u>4"</u> <u>plastic</u> (size) (material)			
(6) pump <u>3/4</u> <u>15</u> (HP) (yield gpm)			
<u>elec.</u> (type power)			
(7) electric log <u>no</u> (yes or no)			
_____ (organization running log)			
(8) how well bottom plugged <u>Cap</u>			
DRILLERS REMARKS: _____			


RECEIVED

OCT 13 1982

DEPT. OF NATURAL RESOURCES  
BUREAU OF LAND & WATER RESOURCES

If well telescopes please sketch and show depths.

GROUND LEVEL

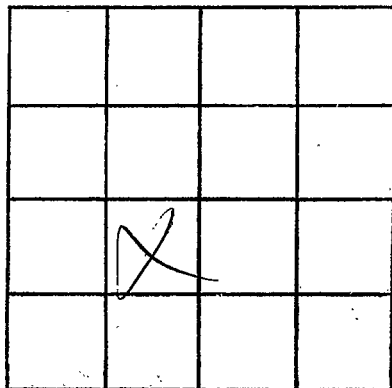

SECTION \_\_\_\_\_

Please indicate well location X.

ADDITIONAL INFORMATION

If more than one screen,  
show locations of each on sketch.