

MISSISSIPPI DEPARTMENT OF NATURAL RESOURCES

Bureau of Land and Water Resources

Southport Mall

P.O. Box 10631

Jackson, Mississippi 39209

WATER WELL DRILLERS LOG

Marshall
A
2006

8-20 1980 firm name Bob Smith Marshall county well located

LANDOWNER:
A. J. Nagurs
Barton
 (mailing address)

description of formations encountered	from	to
<u>top soil</u>		
<u>red clay</u>	<u>0'</u>	<u>5'</u>
<u>gravel</u>	<u>5'</u>	<u>45'</u>
<u>white sand</u>	<u>45'</u>	<u>85'</u>
	<u>85'</u>	<u>135'</u>

WELL LOCATION:
 sec. 30 T 1 N R 4 E
2 miles East of Barton
 (distance) (direction) (nearest town)

WELL PURPOSE:
 (home, irrigation, municipal, industrial)


- WELL COMPLETION DATA:
- (1) diameter (inches) 4 1/4
 - (2) total depth (feet) 135'
 - (3) static water level (feet) 80' below top of ground.
 - (4) casing plastic 135'
 (material) (depth)
 - _____ if telescope see back.
 (size)
 - (5) screen 10' 125'
 (length) (depth to top)
4" plastic
 (size) (material)
 - (6) pump 3/4 15
 (HP) (yield gpm)
ell
 (type power)
 - (7) electric log (yes or no)
 (organization running log)
 - (8) how well bottom plugged Cap

DRILLERS REMARKS:

RECEIVED
 OCT 13 1980
 BUREAU OF LAND & WATER RESOURCES
 DEPT. OF NATURAL RESOURCES

If well telescopes please sketch and show depths.

GROUND LEVEL

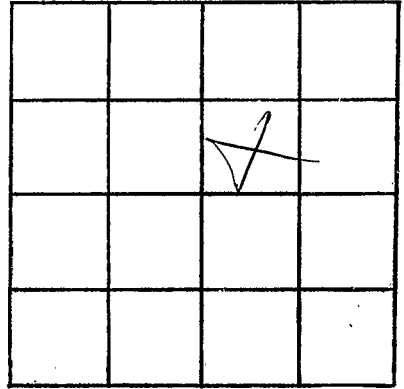

SECTION _____

Please indicate well location X.

ADDITIONAL INFORMATION

If more than one screen,
show locations of each on sketch.