

MISSISSIPPI DEPARTMENT OF NATURAL RESOURCES

Bureau of Land and Water Resources

Southport Mall

P.O. Box 10631

Jackson, Mississippi 39209

WATER WELL DRILLERS LOG

Marshall
A
2027

4-30 1981 Bell Smith Marshall
 date well completed firm name county well located

LANDOWNER:
Dyersville
Barton
 (mailing address)

description of formations encountered	from	to
top soil	0	5
red clay	5	60
red gravel	60	85
white sand	85	105

WELL LOCATION:
 sec 30 T 1 N R 4 E
2 miles EAST of BARTON
 (distance) (direction) (nearest town)

WELL PURPOSE:
 (home, irrigation, municipal, industrial)

WELL COMPLETION DATA:

(1) diameter (inches) 4"

(2) total depth (feet) 185'

(3) static water level (feet) 106' below/above top of ground

(4) casing plastic 185'
 (material) (depth)

_____ if telescope see back.
 (size)

(5) screen 20' 165'
 (length) (depth to top)

2" plastic
 (size) (material)

(6) pump 3/4 15
 (HP) (yield gpm)

elec.
 (type power)

(7) electric log _____
 (yes or no)

_____ (organization running log)

(8) how well bottom plugged cap

RECEIVED


OCT 1 2 1982

DEPT. OF NATURAL RESOURCES
 BUREAU OF LAND AND WATER RESOURCES

DRILLERS REMARKS:

If well telescopes please sketch and show depths.

GROUND LEVEL

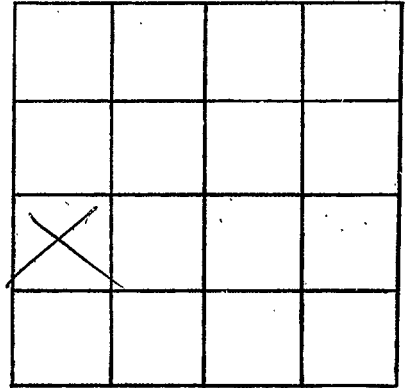

SECTION _____

Please indicate well location X.

ADDITIONAL INFORMATION

If more than one screen,
show locations of each on sketch.