

MISSISSIPPI DEPARTMENT OF NATURAL RESOURCES

Bureau of Land and Water Resources

Southport Mall

P.O. Box 10631

Jackson, Mississippi 39209

WATER WELL DRILLERS LOG

Marshall  
A 2028

4-30-81 19  
date well completed

Bob Smith  
firm name

Marshall  
county well located

LANDOWNER:  
A. S. Magers  
Barton, Miss.  
(mailing address)

description of formations encountered	from	to
<u>top soil</u>	<u>0</u>	<u>5</u>
<u>red clay</u>	<u>5</u>	<u>60</u>
<u>gravel</u>	<u>60</u>	<u>90</u>
<u>white sand</u>	<u>90</u>	<u>185</u>

WELL LOCATION:  
sec 20 T 1 N R 4 E  
4 miles East of Barton  
(distance) (direction) (nearest town)

WELL PURPOSE:  
(home, irrigation, municipal, industrial)

WELL COMPLETION DATA:

- (1) diameter (inches) 4"
- (2) total depth (feet) 185'
- (3) static water level (feet) 105  below  above top of ground.
- (4) casing plastic, 185'  
(material) (depth)  
\_\_\_\_\_ if telescope see back.  
(size)
- (5) screen 20, 165'  
(length) (depth to top)  
4", plastic  
(size) (material)
- (6) pump 3/4, 15  
(HP) (yield gpm)  
elec.  
(type power)
- (7) electric log \_\_\_\_\_  
(yes or no)  
\_\_\_\_\_  
(organization running log)
- (8) how well bottom plugged cap


DRILLERS REMARKS:  
\_\_\_\_\_  
\_\_\_\_\_  
\_\_\_\_\_

RECEIVED  
OCT 13 1982

DEPT. OF NATURAL RESOURCES  
BUREAU OF LAND & WATER RESOURCES

If well telescopes, please sketch and show depths.

GROUND LEVEL

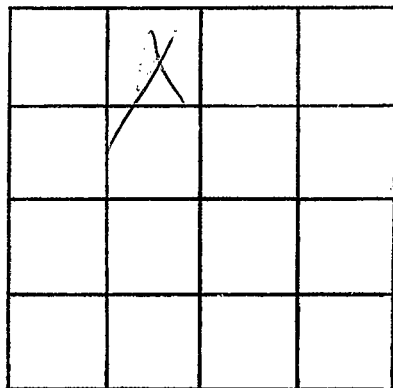

SECTION \_\_\_\_\_

Please indicate well location X.

ADDITIONAL INFORMATION

If more than one screen,  
show locations of each on sketch.