

MISSISSIPPI DEPARTMENT OF NATURAL RESOURCES

Bureau of Land and Water Resources

Southport Mall

P.O. Box 10631

Jackson, Mississippi 39209

WATER WELL DRILLERS LOG

Marshall
A 2031

10-19 1982 Wilson Well Co. Inc. Marshall  
 date well completed firm name county well located

LANDOWNER: Daryl McGavin	description of formations encountered	from	to
9151 Center Hill Road Olive Branch, Miss- (mailing address)			
WELL LOCATION: sec 3/4 T 1 N 5 E 1 miles of Benton (distance) (direction) (nearest town)			
WELL PURPOSE: Home (home, irrigation, municipal, industrial)			
WELL COMPLETION DATA:			
(1) diameter (inches) 4			
(2) total depth (feet) 93			
(3) static water level (feet) 70 below top of ground.			
(4) casing PLASTIC (material) (depth) 4 (size) if telescope see back.			
(5) screen 20 (length) (depth to top) 4 PLASTIC (size) (material)			
(6) pump 3/4 8 (HP) (yield gpm) Electric (type power)			
(7) electric log NO (yes or no)  (organization running log)			
(8) how well bottom plugged 4- PLASTIC CAP			
DRILLERS REMARKS:			


DEPT. OF NATURAL RESOURCES  
 BUREAU OF LAND & WATER RESOURCES

DEC - 1 1982

RECEIVED

If well telescopes please sketch and show depths.

GROUND LEVEL

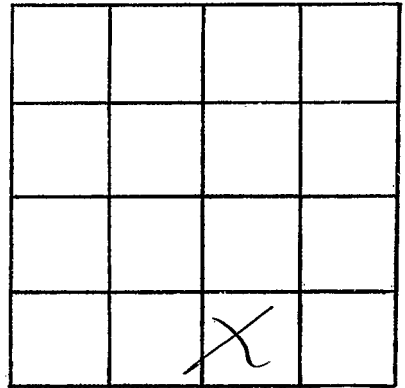

SECTION 36

Please indicate well location X.

ADDITIONAL INFORMATION

A series of horizontal lines for writing additional information.

If more than one screen, show locations of each on sketch.