

MISSISSIPPI DEPARTMENT OF NATURAL RESOURCES

Bureau of Land and Water Resources

Southport Mall

P.O. Box 10631

Jackson, Mississippi 39209

WATER WELL DRILLERS LOG

Marshall  
A 2032

12-14 19 83  
 date well completed

Garnier-Houston Well Co.  
 firm name

Marshall  
 county well located

LANDOWNER: Al Crane

Collierville TN 38017

(mailing address)

WELL LOCATION:

sec. 24 T. 1 N. R. 5 E. W  
1/2 miles (distance) S (direction) of Tennessee (nearest town)

description of formations encountered

from

to

<u>white clay</u>	<u>0</u>	<u>10</u>
<u>Red sand - gravel</u>	<u>10</u>	<u>30</u>
<u>White clay</u>	<u>30</u>	<u>40</u>
<u>" sand</u>	<u>40</u>	<u>81</u>

on Byhalie Rd.

WELL PURPOSE:

(Home) Irrigation, municipal, industrial

WELL COMPLETION DATA:

- (1) diameter (inches) 4
- (2) total depth (feet) 81
- (3) static water level (feet) 40 below top of ground.
- (4) casing plastic (material), 71 (depth)

         if telescope see back.  
 (size)

- (5) screen 10' (length), 71 (depth to top)

4 (size), plastic (material)

- (6) pump 3/4 (HP), 10 (yield gpm)

Electric (type power)

- (7) electric log (yes or no)

         (organization running log)

- (8) how well bottom plugged 4" plastic cap

DRILLERS REMARKS:


DEPT. OF NATURAL RESOURCES  
 BUREAU OF LAND & WATER RESOURCES

JAN 14 1983

RECEIVED

If well telescopes please sketch and show depths.

GROUND LEVEL

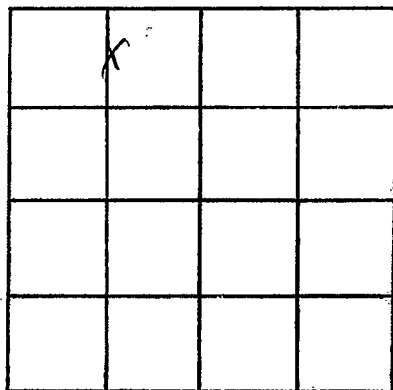

SECTION 24

Please indicate well location X.

ADDITIONAL INFORMATION

If more than one screen,  
show locations of each on sketch.