

MISSISSIPPI DEPARTMENT OF NATURAL RESOURCES

Bureau of Land and Water Resources

Southport Mall

P.O. Box 10631

Jackson, Mississippi 39209

WATER WELL DRILLERS LOG

Marshall
A
2033

Feb-18

1983 Wilson Well Co. Inc

MARSHALL

date well completed

firm name

county well located

LANDOWNER: Daryl McGavin
9151 Center Hill Road
Olive Branch, Miss
(mailing address)

description of formations encountered

from

to

<u>Red Clay - Red Sand</u>	<u>0</u>	<u>30</u>
<u>Red Sand - Yellow Sand</u>	<u>30</u>	<u>60</u>
<u>White Sand</u>	<u>60</u>	<u>95</u>
<u>Blue Clay</u>	<u>95</u>	<u>115</u>
<u>White Sand</u>	<u>115</u>	<u>145</u>

WELL LOCATION:

sec 25 T 1 N R 5
1 miles E of Barter
(distance) (direction) (nearest town)

WELL PURPOSE: Home
(home, irrigation, municipal, industrial)

WELL COMPLETION DATA:

- (1) diameter (inches) 4
- (2) total depth (feet) 145
- (3) static water level (feet) 75 below above top of ground.
- (4) casing Plastic, 145,
(material) (depth)
4 if telescope see back.
(size)
- (5) screen 10,
(length) (depth to top)
4, Plastic
(size) (material)
- (6) pump 3/4 8
(HP) (yield gpm)
Electric
(type power)
- (7) electric log No
(yes or no)
(organization running log)
- (8) how well bottom plugged 4"
Plastic CAP

DRILLERS REMARKS: Re-Drill


DEPT. OF NATURAL RESOURCES
BUREAU OF LAND & WATER RESOURCES

MAR 30 1983

RECEIVED

If well telescopes please sketch and show depths.

GROUND LEVEL

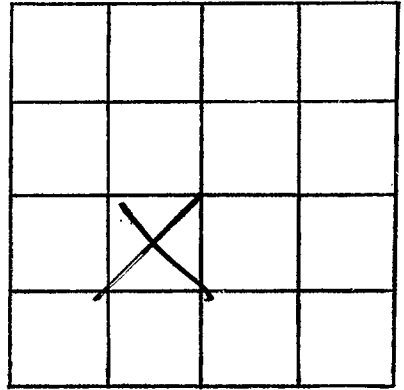

SECTION 25

Please indicate well location X.

ADDITIONAL INFORMATION

If more than one screen,
show locations of each on sketch.