


**MISSISSIPPI DEPARTMENT OF NATURAL RESOURCES**  
**Bureau of Land and Water Resources**  
 Southport Mall  
 P.O. Box 10631  
 Jackson, Mississippi 39209  
**WATER WELL DRILLERS LOG**

Marshall  
 A  
2034

6-14 1983 Janner Houston Wells Marshall  
 date well completed firm name county well located

LANDOWNER: B. B. C. Land Co  
P.O. Box 354  
Collinsville, TN  
 (mailing address)

description of formations encountered	from	to
	<u>Brown Clay</u>	<u>0</u>
<u>Red Sand</u>	<u>15</u>	<u>40</u>
<u>White Sand</u>	<u>40</u>	<u>150</u>

WELL LOCATION:  
 sec. 13 T. 1 N. R. 5 E.  
8 miles N of Byhalia  
 (distance) (direction) (nearest town)

WELL PURPOSE:  
~~(home, irrigation, municipal, industrial)~~

- WELL COMPLETION DATA:
- (1) diameter (inches) 4
  - (2) total depth (feet) 150
  - (3) static water level (feet) 60 below above top of ground
  - (4) casing Plastr 90  
 (material) (depth)  
4 if telescope see back.  
 (size)
  - (5) screen 10' 90  
 (length) (depth to top)  
4 Plastr  
 (size) (material)
  - (6) pump 1 20  
 (HP) (yield gpm)  
Electric  
 (type power)
  - (7) electric log (yes or no)  
 (organization running log)
  - (8) how well bottom plugged 4  
Plastr cap

DRILLERS REMARKS:


DEPT. OF NATURAL RESOURCES  
 BUREAU OF LAND & WATER RESOURCES

**JUL 18 1983**

**RECEIVED**

If well telescopes please  
sketch and show depths.

GROUND LEVEL

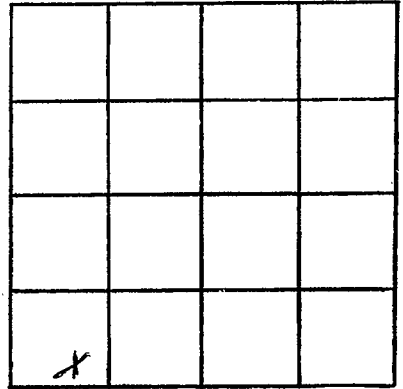

SECTION 13

Please indicate well location X.

ADDITIONAL INFORMATION

If more than one screen,  
show locations of each on sketch.