

MISSISSIPPI DEPARTMENT OF NATURAL RESOURCES

Bureau of Land and Water Resources

Southport Mall

P.O. Box 10631

Jackson, Mississippi 39209

WATER WELL DRILLERS LOG

Marshall
A
2037

10-25 19 83 Garner Houston Well Co Marshall  
 date well completed firm name county well located

LANDOWNER: Enterprise Recovery System  
 P.O. Box 567  
 Collierville TN 38017  
 (mailing address)

description of formations encountered	from	to
White Clay	0	40
yellow sand	40	70
White Sand	70	140
white Clay	140	195
white sand	195	250

WELL LOCATION:  
 sec. 22 T 1 N R 4 E  
 4 miles SE of Barton  
 (distance) (direction) (nearest town)

WELL PURPOSE:  
 (Irrigation, municipal, industrial)

- WELL COMPLETION DATA:
- (1) diameter (inches) 6
  - (2) total depth (feet) 250
  - (3) static water level (feet) 70 below top of ground.
  - (4) casing plastic (material), (depth)
  - 6 (size) if telescope see back.
  - (5) screen 70 (length), 180 (depth to top)
  - 4 (size), Plastic (material)
  - (6) pump 15 (HP), 225 (yield gpm)
  - Elec (type power)
  - (7) electric log (yes or no)
  - (organization running log)

(8) how well bottom plugged  
 plug

DRILLERS REMARKS:


DEPT. OF NATURAL RESOURCES  
 BUREAU OF LAND & WATER RESOURCES

JAN 9 - 1984  
 RECEIVED

(X)

If well telescopes please sketch and show depths.

GROUND LEVEL

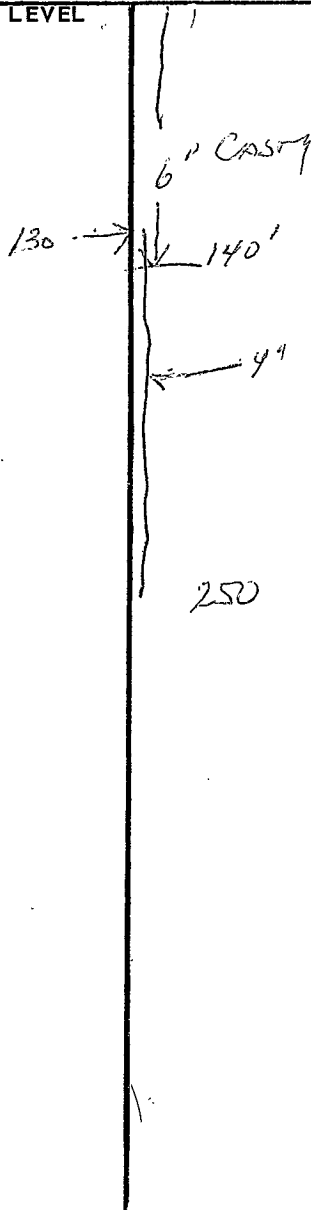

				X

SECTION 22

Please indicate well location X.

ADDITIONAL INFORMATION

If more than one screen, show locations of each on sketch.