

Marshall  
A  
2038

MISSISSIPPI DEPARTMENT OF NATURAL RESOURCES  
Bureau of Land and Water Resources  
Southport Mall  
P.O. Box 10631  
Jackson, Mississippi 39209  
WATER WELL DRILLERS LOG

1-10 date well completed      1984 Wilson well Co-Inc- firm name      Marshall county well located

LANDOWNER: Wayne Maroney description of formations encountered      from      to  
Route 5      Brown Clay      0      18  
Byhalia, Ms.      White Sand      18      105  
(mailing address)

WELL LOCATION:  
sec 22 T 1 N 3 R 4 E  
3 miles N of Byhalia  
(distance) (direction) (nearest town)

WELL PURPOSE: Home  
(home, irrigation, municipal, industrial)

- WELL COMPLETION DATA:
- (1) diameter (inches) 4
  - (2) total depth (feet) 100
  - (3) static water level (feet) 70 below top of ground.
  - (4) casing Plastic, 100  
(material) (depth)  
4 if telescope see back.  
(size)
  - (5) screen 10, (depth to top)  
(length)  
4, Plastic  
(size) (material)
  - (6) pump 3/4, 8  
(HP) (yield gpm)  
Elec  
(type power)
  - (7) electric log (yes or no) no  
(organization running log)

(8) how well bottom plugged 4-PRC CAP

DRILLERS REMARKS:


DEPT. OF NATURAL RESOURCES  
BUREAU OF LAND & WATER RESOURCES

MAR - 8 1984

RECEIVED

If well telescopes please sketch and show depths.

GROUND LEVEL

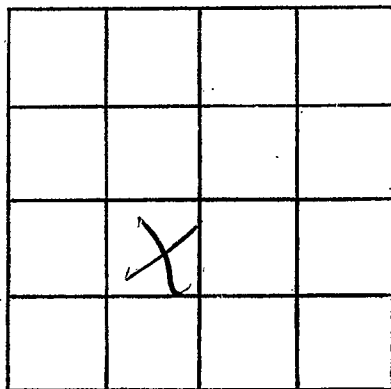

SECTION 22

Please indicate well location X.

ADDITIONAL INFORMATION

If more than one screen, show locations of each on sketch.