

MISSISSIPPI DEPARTMENT OF NATURAL RESOURCES  
 Bureau of Land and Water Resources  
 Southport Mall  
 P.O. Box 10631  
 Jackson, Mississippi 39209  
**WATER WELL DRILLERS LOG**

Marshall  
A 2039

1-11 date well completed    1984 Wilson Well Co. Inc firm name    Marshall county well located

LANDOWNER: John Tutor  
Rt. 5 Box 291  
Byhalia, MS.  
 (mailing address)

WELL LOCATION:  
 sec 22 T 1 N R 4 E  
3 miles N of Byhalia  
 (distance) (direction) (nearest town)

description of formations encountered	from	to
	<u>Brown Clay</u>	<u>0</u>
<u>White Sand</u>	<u>17</u>	<u>70</u>
<u>White Clay</u>	<u>70</u>	<u>72</u>
<u>White Sand</u>	<u>72</u>	<u>117</u>

WELL PURPOSE: None  
 (home, irrigation, municipal, industrial)

- WELL COMPLETION DATA:
- diameter (inches) 4
  - total depth (feet) 117
  - static water level (feet) 70 below top of ground
  - casing Plastic (material), (depth)  
4 (size) if telescope see back.
  - screen 10 (length), (depth to top)  
4 (size), Plastic (material)
  - pump 1 (HP), 12 (yield gpm)  
Elec (type power)
  - electric log (yes or no) X  
 (organization running log)
  - how well bottom plugged 4-PVCCAP

DRILLERS REMARKS:


DEPT. OF NATURAL RESOURCES  
 BUREAU OF LAND & WATER RESOURCES

MAR 8 1984

**RECEIVED**

If well telescopes please  
sketch and show depths.

GROUND LEVEL

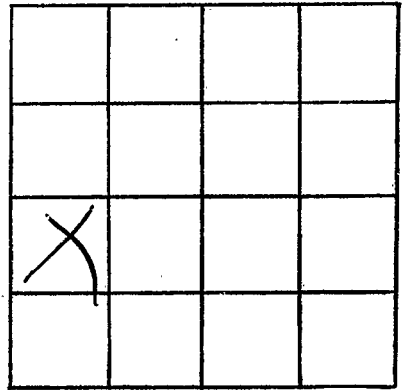

SECTION 22

Please indicate well location X.

ADDITIONAL INFORMATION

If more than one screen,  
show locations of each on sketch.