

MISSISSIPPI DEPARTMENT OF NATURAL RESOURCES

Bureau of Land and Water Resources

Southport Mall

P.O. Box 10631

Jackson, Mississippi 39209

WATER WELL DRILLERS LOG

Marshall
A 2040

1/26/84
date well completed

Gullett well Drilling Marshall
firm name

county well located

LANDOWNER: Ed Gasset

description of formations encountered

from

to

Red Clay

0

30

Clay and Sand

30

120

(mailing address)

WELL LOCATION:

sec. 22 T 1 N R 4 E
5 miles S E of Calhoun
(distance) (direction) (nearest town)

WELL PURPOSE:

(home, irrigation, municipal, industrial)

WELL COMPLETION DATA:

- (1) diameter (inches) 4"
- (2) total depth (feet) 120'
- (3) static water level (feet) 80 below top of ground.
- (4) casing PVC, 110 (material) (depth)
- (size) if telescope see back.
- (5) screen 10' (length), 110 (depth to top)
- 4" (size) PVC (material)
- (6) pump 1HP, 20 (HP) (yield gpm)
- split (type power)
- (7) electric log No (yes or no)

(organization running log)

(8) how well bottom plugged Long

DRILLERS REMARKS:


DEPT. OF NATURAL RESOURCES
BUREAU OF LAND & WATER RESOURCES

APR 26 1984

RECEIVED

If well telescopes please sketch and show depths.

GROUND LEVEL

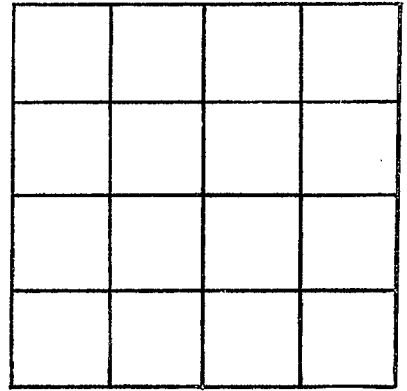

SECTION _____

Please indicate well location X.

ADDITIONAL INFORMATION

If more than one screen,
show locations of each on sketch.