

MARSHALL
A 2041

MISSISSIPPI DEPARTMENT OF NATURAL RESOURCES
 Bureau of Land and Water Resources
 Southport Mall
 P.O. Box 10631
 Jackson, Mississippi 39209
WATER WELL DRILLERS LOG

4-17 1985
 date well completed

Lang Capstan Well Co.
 firm name

Marshall
 county well located

LANDOWNER: Blr Home

Rt 5, Bayala, ms

38611

(mailing address)

WELL LOCATION:

sec 34 T 1 N R 4 E
 S W
1/2 miles East of Cape
 (distance) (direction) (nearest town)

WELL PURPOSE: Home
 (home, irrigation, municipal, industrial)

WELL COMPLETION DATA:

- (1) diameter (inches) 4
- (2) total depth (feet) 126
- (3) static water level (feet) 80 below top of ground.
- (4) casing PVC, 116'
 (material) (depth)
 (size) if telescope see back.
- (5) screen 10', 116
 (length) (depth to top)
4", PVC
 (size) (material)
- (6) pump 3/4, 12
 (HP) (yield gpm)
Blr
 (type power)
- (7) electric log No
 (yes or no)


(organization running log)

(8) how well bottom plugged PVC Cap

description of formations encountered

from to

<u>Surface Soil</u>	<u>0</u>	<u>18</u>
<u>Med. Red Sand</u>	<u>18</u>	<u>40</u>
<u>Med. White Sand</u>	<u>40</u>	<u>65</u>
<u>White Clay</u>	<u>65</u>	<u>83</u>
<u>White Coarse Sand</u>	<u>83</u>	<u>126</u>

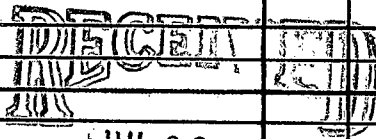


JUL 23 1986

Department of Natural Resources
 Bureau of Land & Water Resources

DRILLERS REMARKS:

If well telescopes please sketch and show depths.

GROUND LEVEL

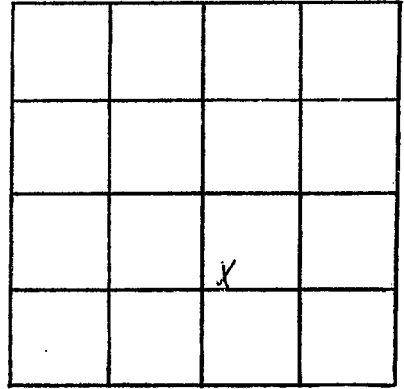

SECTION 34

Please indicate well location X.

ADDITIONAL INFORMATION

If more than one screen, show locations of each on sketch.