

MISSISSIPPI DEPARTMENT OF NATURAL RESOURCES
 Bureau of Land and Water Resources
 Southport Mall
 P.O. Box 10631
 Jackson, Mississippi 39209
WATER WELL DRILLERS LOG

MARSHALL
A 2042

5-30

19 85 Long Carpenter Well Co

Marshall

date well completed

firm name

county well located

LANDOWNER: J. W. Cobb

Bygdalia, Ms.

RFD

(mailing address)

WELL LOCATION:

sec. 23 T 1 N R 5 E

S W

1 miles North of Barton
 (distance) (direction) (nearest town)

WELL PURPOSE: Home
 (home, irrigation, municipal, industrial)

WELL COMPLETION DATA:


- (1) diameter (inches) 4
- (2) total depth (feet) 126
- (3) static water level (feet) 60 below above top of ground.
- (4) casing PVC, 116'
 (material) (depth)
 (size) if telescope see back.
- (5) screen 10', 116'
 (length) (depth to top)
1/2", PVC
 (size) (material)
- (6) pump 1/2 (HP) 10 (yield gpm)
Elec.
 (type power)
- (7) electric log no
 (yes or no)
 (organization running log)
- (8) how well bottom plugged PVC Cap

description of formations encountered

from

to

<u>Surface Soil</u>	<u>0</u>	<u>20</u>
<u>Med. Red Sand</u>	<u>20</u>	<u>36</u>
<u>Med. White Sand</u>	<u>36</u>	<u>60</u>
<u>White coarse Sand</u>	<u>60</u>	<u>85</u>
<u>White Clay</u>	<u>85</u>	<u>95</u>
<u>White coarse Sand</u>	<u>95</u>	<u>126</u>

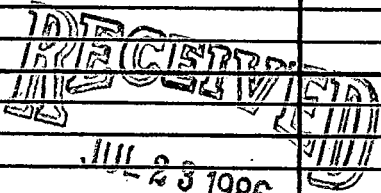


Department of Natural Resources
 Bureau of Land & Water Resources

DRILLERS REMARKS:

If well telescopes please sketch and show depths.

GROUND LEVEL

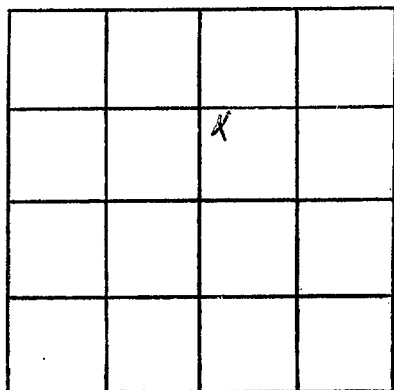

SECTION 23

Please indicate well location X.

ADDITIONAL INFORMATION

If more than one screen,
show locations of each on sketch.