

MISSISSIPPI DEPARTMENT OF NATURAL RESOURCES

Bureau of Land and Water Resources

Southport Mall

P.O. Box 10631

Jackson, Mississippi 39209

WATER WELL DRILLERS LOG

MARSHALL
A 2043

6-10 1985
date well completed

85 Larry Carpenter Well Co
firm name

Marshall
county well located

LANDOWNER: Joe Kemp

Byhalia, ms

RFD
(mailing address)

description of formations encountered

from

to

Surface Soil

0

15

Med. Red Sand

15

38

Med. white sand

38

65

white clay

65

90

white coarse sand

90

129

WELL LOCATION:

sec 36 T 1 N R 4 E
S W

1/2 miles East of Cayce
(distance) (direction) (nearest town)

WELL PURPOSE: Home
(home, irrigation, municipal, industrial)

WELL COMPLETION DATA:

- (1) diameter (inches) 4
- (2) total depth (feet) 129
- (3) static water level (feet) 70 below above top of ground.
- (4) casing PVC, 119'
(material) (depth)

_____ if telescope see back.
(size)

- (5) screen 10', 119'
(length) (depth to top)

4 in., PVC
(size) (material)

- (6) pump 1/2, 10
(HP) (yield gpm)


3 hp
(type power)

- (7) electric log No.
(yes or no)

_____ (organization running log)

- (8) how well bottom plugged PVC caps

DRILLERS REMARKS:

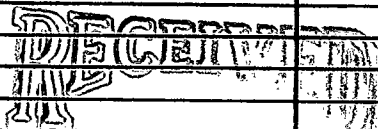

III 29 1986

Department of Natural Resources
Bureau of Land and Water Resources

If well telescopes please sketch and show depths.

GROUND LEVEL

	X		

SECTION 34

Please indicate well location X.

ADDITIONAL INFORMATION

If more than one screen, show locations of each on sketch.