

MARSHALL
A 2044

MISSISSIPPI DEPARTMENT OF NATURAL RESOURCES
Bureau of Land and Water Resources
Southport Mall
P.O. Box 10631
Jackson, Mississippi 39209
WATER WELL DRILLERS LOG

6-71-1985 date well completed
Long Carpenter Wells firm name
Marshall county well located

LANDOWNER: Jim Turner
By: [Signature]
RF D
(mailing address)

WELL LOCATION:
sec. 34 T. 1 N R. 4 E
1/2 miles East of Cozue
(distance) (direction) (nearest town)

WELL PURPOSE: Home
(home, irrigation, municipal, industrial)

- WELL COMPLETION DATA:
- (1) diameter (inches) 4
 - (2) total depth (feet) 165
 - (3) static water level (feet) 90 below above top of ground.
 - (4) casing PVC, 155' (material), (depth)
(size) if telescope see back.
 - (5) screen 10', 155' (length), (depth to top)
4" PVC (size), (material)
 - (6) pump 1/2 (HP), 10 (yield gpm)
Elec. (type power)
 - (7) electric log no (yes or no)
(organization running log)
 - (8) how well bottom plugged PVC Cap

description of formations encountered	from	to
Surface Soil	0	20
Med. Red Sand	20	45
Med. White Sand	45	70
white clay	70	105
Fine White Sand	105	140
White Coarse Sand	140	165


RECEIVED
JUL 23 1986

Department of Natural Resources
Bureau of Land & Water Resources

DRILLERS REMARKS:

If well telescopes please
sketch and show depths.

GROUND LEVEL

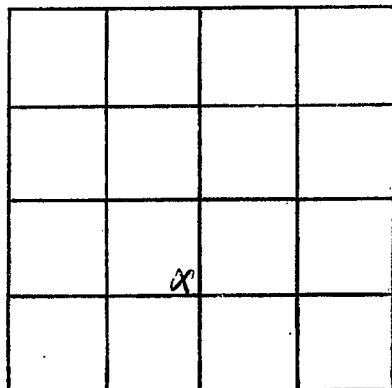

SECTION 34

Please indicate well location X.

ADDITIONAL INFORMATION

If more than one screen,
show locations of each on sketch.