

MARSHALL  
A 2045

MISSISSIPPI DEPARTMENT OF NATURAL RESOURCES  
Bureau of Land and Water Resources  
Southport Mall  
P.O. Box 10631  
Jackson, Mississippi 39209  
**WATER WELL DRILLERS LOG**

7-28 1985 Larry Carpenter Well Co Marshall  
date well completed firm name county well located

LANDOWNER: Mr. Floyd Fields  
Byhalia, Ms.  
RFD  
(mailing address)

WELL LOCATION:  
sec. 22 T 1 N R 4 E  
S W  
2 miles North of Coyne  
(distance) (direction) (nearest town)

WELL PURPOSE: Home  
(home, irrigation, municipal, industrial)

WELL COMPLETION DATA:

- (1) diameter (inches) 4
- (2) total depth (feet) 114
- (3) static water level (feet) 75 below above top of ground.
- (4) casing PVC, 104'  
(material) (depth)  
(size) if telescope see back.
- (5) screen 10', 104'  
(length) (depth to top)  
4in., PVC  
(size) (material)
- (6) pump 1/2, 10  
(HP) (yield gpm)  
Elco  
(type power)
- (7) electric log No  
(yes or no)  
(organization running log)
- (8) how well bottom plugged PVC cap

description of formations encountered	from	to
<u>Surface Soil</u>	<u>0</u>	<u>18</u>
<u>Med. Red Sand</u>	<u>18</u>	<u>40</u>
<u>Med. White Sand</u>	<u>40</u>	<u>80</u>
<u>White Clay + Fine Sand</u>	<u>80</u>	<u>88</u>
<u>White. Coarse Sand</u>	<u>88</u>	<u>114</u>


RECEIVED  
JUL 23 1986

Department of Natural Resources  
Bureau of Land & Water Resources

DRILLERS REMARKS:

If well telescopes please sketch and show depths.

GROUND LEVEL

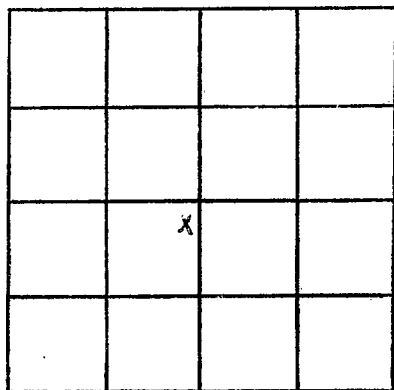

SECTION 22

Please indicate well location X.

ADDITIONAL INFORMATION

If more than one screen, show locations of each on sketch.