

MISSISSIPPI DEPARTMENT OF NATURAL RESOURCES

Bureau of Land and Water Resources

Southport Mall

P.O. Box 10631

Jackson, Mississippi 39209

WATER WELL DRILLERS LOG

MARSHALL
A 2046

7-24
date well completed

1985 Long Capester Wells
firm name

Marshall
county well located

LANDOWNER: Arten Cousins

Byhalia, ms

RFD

(mailing address)

WELL LOCATION:

sec. 34 T-1 N R-4 E
S W
3/4 miles East of Cayce
(distance) (direction) (nearest town)

WELL PURPOSE: Home
(home, irrigation, municipal, industrial)

WELL COMPLETION DATA:

- (1) diameter (inches) 4
- (2) total depth (feet) 130
- (3) static water level (feet) 70 below above top of ground.
- (4) casing PVC, 120'
(material) (depth)
(size) if telescope see back.
- (5) screen 10', 120'
(length) (depth to top)
Home, PVC
(size) (material)
- (6) pump 1/2, 10
(HP) (yield gpm)
Electric
(type power)
- (7) electric log no
(yes or no)

(organization running log)

(8) how well bottom plugged PVC cap

description of formations encountered

from

to

<u>Surface Soil</u>	<u>0</u>	<u>20</u>
<u>Med Red. Sand</u>	<u>20</u>	<u>35</u>
<u>Med. & Fine White Sand</u>	<u>35</u>	<u>68</u>
<u>White Clay</u>	<u>68</u>	<u>90</u>
<u>White coarse Sand</u>	<u>90</u>	<u>130</u>




JUL 23 1986

Department of Natural Resources
Bureau of Land & Water Resources

DRILLERS REMARKS:

If well telescopes please sketch and show depths.

GROUND LEVEL

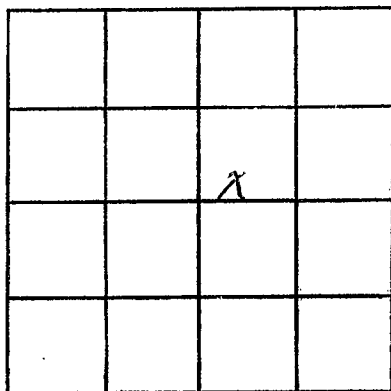

SECTION 34

Please indicate well location X.

ADDITIONAL INFORMATION

If more than one screen, show locations of each on sketch.