

MISSISSIPPI DEPARTMENT OF NATURAL RESOURCES
Bureau of Land and Water Resources
 Southport Mall
 P.O. Box 10631
 Jackson, Mississippi 39209
WATER WELL DRILLERS LOG

Marshall
A 2048

8-2 1985 Larry Carpenter, Will C. Marshall
 date well completed firm name county well located

LANDOWNER William Sharp
Byhalia, Ms.
R. F. D.
 (mailing address)

description of formations encountered	from	to
<u>Surface Soil</u>	<u>0</u>	<u>19</u>
<u>Med Red sand</u>	<u>19</u>	<u>38</u>
<u>Med. + Fine White sand</u>	<u>38</u>	<u>65</u>
<u>White Clay</u>	<u>65</u>	<u>90</u>
<u>White Coarse sand</u>	<u>90</u>	<u>118</u>

WELL LOCATION:
 sec. 34 T 1 N R 4 E
 S W
3/4 miles East of Coyce
 (distance) (direction) (nearest town)

WELL PURPOSE: Home
 (home, irrigation, municipal, industrial)

- WELL COMPLETION DATA:
- (1) diameter (inches) .4
 - (2) total depth (feet) 118'
 - (3) static water level (feet) 75 below top of ground.
 - (4) casing PVC, 108'
 (material) (depth)
 (size) if telescope see back.
 - (5) screen 10', 108'
 (length) (depth to top)
4 in, PVC
 (size) (material)
 - (6) pump 1/2, 10 gal
 (HP) (yield/gpm)
3 hp
 (type power)
 - (7) electric log no
 (yes or no)
 (organization running log)
 - (8) how well bottom plugged PVC Cap


RECEIVED
JUL 23 1986

Department of Natural Resources
 Bureau of Land & Water Resources

DRILLERS REMARKS:

If well telescopes please
sketch and show depths.

GROUND LEVEL

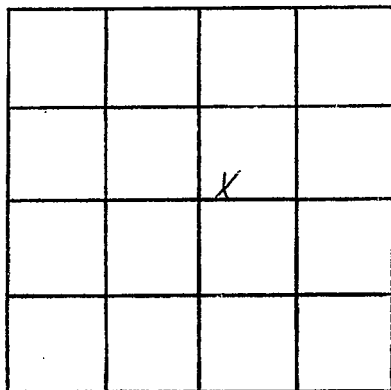

SECTION 24

Please indicate well location X.

ADDITIONAL INFORMATION

If more than one screen,
show locations of each on sketch.