

MISSISSIPPI DEPARTMENT OF NATURAL RESOURCES

Bureau of Land and Water Resources

Southport Mall

P.O. Box 10631

Jackson, Mississippi 39209

WATER WELL DRILLERS LOG

MARSHALL
A 2049

8-15 1985 Larry Carpenter, W.M. Marshall
date well completed firm name county well located


LANDOWNER: Mildred Perment
Bayalia Ms.
R. F. D.
(mailing address)

description of formations encountered	from	to
<u>Surface Soil</u>	<u>0</u>	<u>16</u>
<u>Med Red sand</u>	<u>16</u>	<u>35</u>
<u>Med White sand</u>	<u>35</u>	<u>68</u>
<u>White Clay</u>	<u>68</u>	<u>90</u>
<u>White Coarse sand</u>	<u>90</u>	<u>120</u>

WELL LOCATION:
sec. 34 T 1 N R 4 E
S W
1/2 miles East of Coyce
(distance) (direction) (nearest town)

WELL PURPOSE: Home
(home, irrigation, municipal, industrial)

- WELL COMPLETION DATA:
- (1) diameter (inches) 4
 - (2) total depth (feet) 120'
 - (3) static water level (feet) 70 below above top of ground.
 - (4) casing PVC, 110'
(material) (depth)
(size) if telescope see back.
 - (5) screen 10', 110'
(length) (depth to top)
4in, PVC
(size) (material)
 - (6) pump 1/2, 10
(HP) (yield gpm)
Elec.
(type power)
 - (7) electric log No
(yes or no)
(organization running log)
 - (8) how well bottom plugged PVC cap

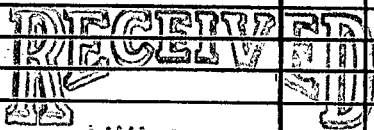


JUL 23 1986

Department of Natural Resources
Bureau of Land & Water Resources

DRILLERS REMARKS:

If well telescopes please sketch and show depths.

GROUND LEVEL

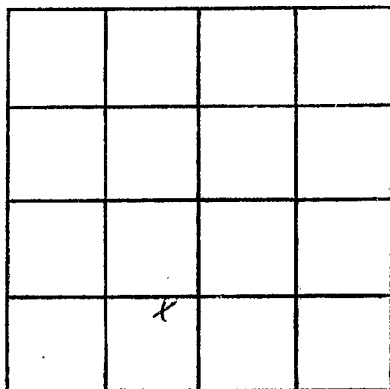

SECTION 34

Please indicate well location X.

ADDITIONAL INFORMATION

If more than one screen,
show locations of each on sketch.