

MARSHALL
A 2050

MISSISSIPPI DEPARTMENT OF NATURAL RESOURCES
Bureau of Land and Water Resources
Southport Mall
P.O. Box 10631
Jackson, Mississippi 39209
WATER WELL DRILLERS LOG

8-29
date well completed

1985 Larry Carpenter Wells Marshall
firm name county well located

LANDOWNER: Richard Pierre

Byhalia, Inc

RFD

(mailing address)

description of formations encountered

from

to

Surface Soil

0

15

Med. Red. Sand

15

35

White. Clay

35

60

Med. White Sand

60

84

White Coarse Sand

84

115

WELL LOCATION:

sec. 2 T 1 N R 4 E
S W
2 miles north of Cayce
(distance) (direction) (nearest town)

WELL PURPOSE: Home
(home, irrigation, municipal, industrial)

WELL COMPLETION DATA:

- (1) diameter (inches) 4
(2) total depth (feet) 115
(3) static water level (feet) 68 below above top of ground.

(4) casing PVC, 105'
(material) (depth)

(size) if telescope see back.

(5) screen 10', 105'
(length) (depth to top)

4 in, PVC
(size) (material)

(6) pump 1/2, 10
(HP) (yield gpm)

2 hp
(type power)

(7) electric log No
(yes or no)

(organization running log)

(8) how well bottom plugged PVC Cap


DRILLERS REMARKS:

RECEIVED
JUL 23 1986

Department of Natural Resources
Bureau of Land and Water Resources

If well telescopes please sketch and show depths.

GROUND LEVEL

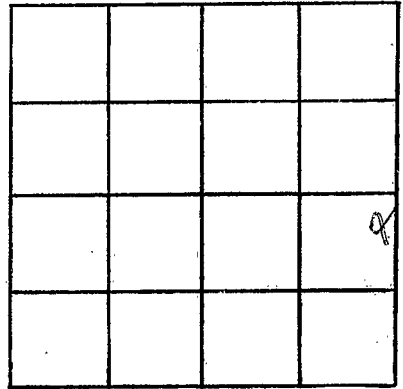

SECTION 21

Please indicate well location X.

ADDITIONAL INFORMATION

If more than one screen,
show locations of each on sketch.