

Marshall  
A 2057

MISSISSIPPI DEPARTMENT OF NATURAL RESOURCES  
Bureau of Land and Water Resources  
Southport Mall  
P.O. Box 10631  
Jackson, Mississippi 39209  
**WATER WELL DRILLERS LOG**

9-10 1985 Larry Carpenter Wells Marshall  
date well completed firm name county well located

LANDOWNER: Charles Wiggs  
Byhalia, ms.  
RFD  
(mailing address)


WELL LOCATION:  
sec 23 T 1 N R 5 E  
S W  
1 miles north of Barton  
(distance) (direction) (nearest town)

WELL PURPOSE: Home  
(home, irrigation, municipal, industrial)

WELL COMPLETION DATA:

- (1) diameter (inches) 4
- (2) total depth (feet) 125
- (3) static water level (feet) 75 below above top of ground.
- (4) casing PVC, 115'  
(material) (depth)  
(size) If telescope see back.
- (5) screen 10', 115'  
(length) (depth to top)  
1/2", PVC  
(size) (material)
- (6) pump 1/2, 10  
(HP) (yield gpm)  
Elec.  
(type power)
- (7) electric log no  
(yes or no)  
(organization running log)
- (8) how well bottom plugged PVC Casing

description of formations encountered	from	to
<u>Surface Soil</u>	<u>0</u>	<u>21</u>
<u>red Red Sand</u>	<u>21</u>	<u>35</u>
<u>red white sand</u>	<u>35</u>	<u>63</u>
<u>white coarse sand</u>	<u>63</u>	<u>84</u>
<u>white clay</u>	<u>84</u>	<u>90</u>
<u>white coarse sand</u>	<u>90</u>	<u>125</u>

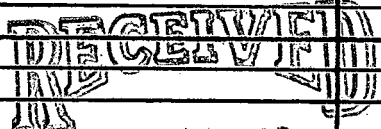


JUL 23 1985

Department of Natural Resources  
Bureau of Land & Water Resources

DRILLERS REMARKS:

If well telescopes please sketch and show depths.

GROUND LEVEL

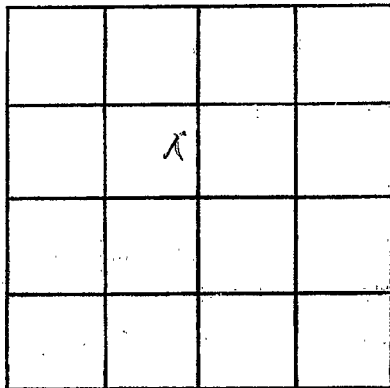

SECTION 23

Please indicate well location X.

ADDITIONAL INFORMATION

If more than one screen,  
show locations of each on sketch.