

MISSISSIPPI DEPARTMENT OF NATURAL RESOURCES

Bureau of Land and Water Resources

Southport Mall

34-56-32

P.O. Box 10631

89-36-09

Jackson, Mississippi 39209

WATER WELL DRILLERS LOG

Marshall
A 2053

12-6
date well completed

1985 Larry Carpenter Well Co
firm name

Marshall
county well located

LANDOWNER: Steve Harper

Byrdale, Ms

RFD

(mailing address)

description of formations encountered

from

to

Surface Soil 0 15

Med. Red Sand 15 36

Coarse White Sand 36 70

Fine White Sand 70 84

White Coarse Sand 80 107

WELL LOCATION:

sec. 3 T. 1 N. R. 4 E. (W)
1 miles SE of Cape
(distance) (direction) (nearest town)

WELL PURPOSE: Home
(home, irrigation, municipal, industrial)

WELL COMPLETION DATA:

- (1) diameter (inches) 4
- (2) total depth (feet) 107
- (3) static water level (feet) 52 below above top of ground.

(4) casing PVC, 97'
(material) (depth)
(size) If telescope see back.


(5) screen 10', 97'
(length) (depth to top)
4", PVC
(size) (material)

(6) pump 1/2, 10
(HP) (yield gpm)
Elec
(type power)

(7) electric log No
(yes or no)

(organization running log)

(8) how well bottom plugged PVC Cap

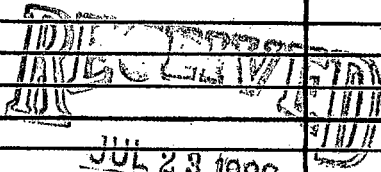

Department of Natural Resources
Bureau of Land and Water Resources

DRILLERS REMARKS:

If well telescopes please sketch and show depths.

GROUND LEVEL

			α

SECTION 3

Please indicate well location X.

ADDITIONAL INFORMATION

If more than one screen, show locations of each on sketch.