

MISSISSIPPI DEPARTMENT OF NATURAL RESOURCES  
 Bureau of Land and Water Resources  
 Southport Mall  
 P.O. Box 10631  
 Jackson, Mississippi 39209  
**WATER WELL DRILLERS LOG**

Marshall  
A 2054

12-10-1985 date well completed      Lang Carpenter Wells firm name      Marshall county well located

LANDOWNER: Russ Kinard  
Rehoboth, Ms  
RFD  
 (mailing address)

description of formations encountered	from	to
Surface Soil	0	20
Med. Red Sand	20	34
Med. White Sand	34	60
White coarse sand	60	82
White clay	82	94
White coarse sand	94	126

WELL LOCATION:  
 sec 23 T 1 N R 5 E  
1 miles north of Barton  
 (distance) (direction) (nearest town)

WELL PURPOSE: Home  
 (home, irrigation, municipal, industrial)

WELL COMPLETION DATA:

- (1) diameter (inches) 4  
 (2) total depth (feet) 126  
 (3) static water level (feet) 75 below above top of ground.  
 (4) casing PVC, 116'  
 (material) (depth)

\_\_\_\_\_ if telescope see back.  
 (size)

- (5) screen 10', 116'  
 (length) (depth to top)  
4", PVC  
 (size) (material)

- (6) pump 1/2, 10  
 (HP) (yield gpm)

Elec.  
 (type power)

- (7) electric log no  
 (yes or no)

\_\_\_\_\_ (organization running log)

- (8) how well bottom plugged PVC cap


DRILLERS REMARKS:

DEPARTMENT OF NATURAL RESOURCES  
 MISSISSIPPI  
 JUL 23 1986

MISSISSIPPI DEPARTMENT OF NATURAL RESOURCES  
 BUREAU OF LAND AND WATER RESOURCES  
 SOUTHPORT MALL  
 JACKSON, MISSISSIPPI 39209

If well telescopes please sketch and show depths.

GROUND LEVEL

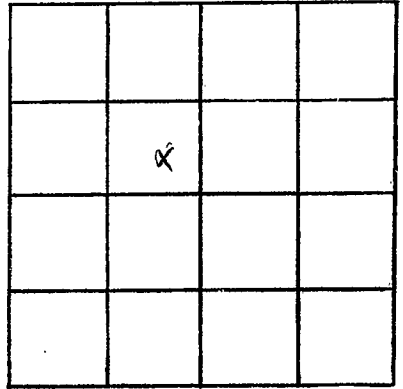

SECTION 23

Please indicate well location X.

ADDITIONAL INFORMATION

Multiple horizontal lines for additional information.

If more than one screen, show locations of each on sketch.